


T.36S.,R.10E.,W.M.

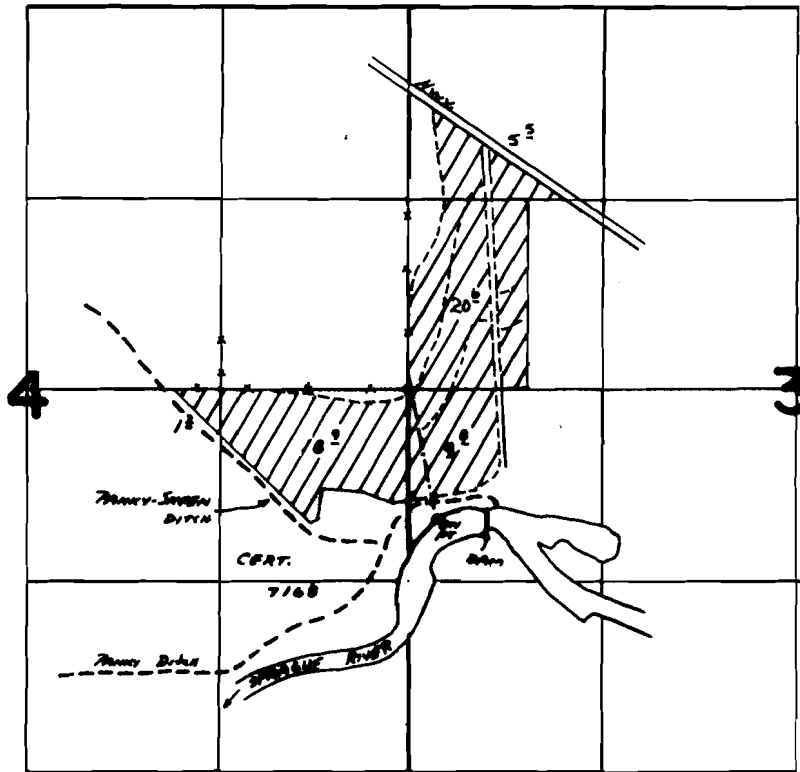

DIV. PT. - 176'S AND 200'E FROM W/4 COR SEC 3

FINAL PROOF SURVEY UNDER

54626 40988
Application No. 46932. Permit No. 34878.
IN NAME OF

BILL & ROSALYN HARRIS

Surveyed JULY 10, 1975, by A.E. Gault

48030
44490