


G6648  
48033

# T.31S. R.16E., W.M.

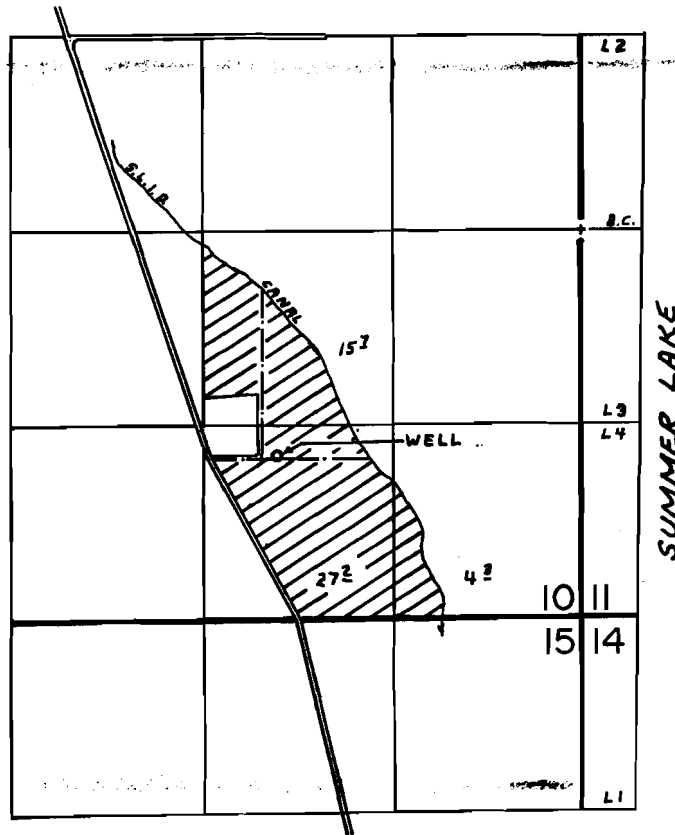

WELL LOC. 1540' S. & 2090' W. FROM E. 1/4 COR. SEC. 10

## FINAL PROOF SURVEY UNDER

Application No. G-7244. Permit No. G-6648.  
IN NAME OF

.....JEREMIAH O'LEARY.....

Surveyed JUL. 20., 1977., by D.M. NORBY.....