



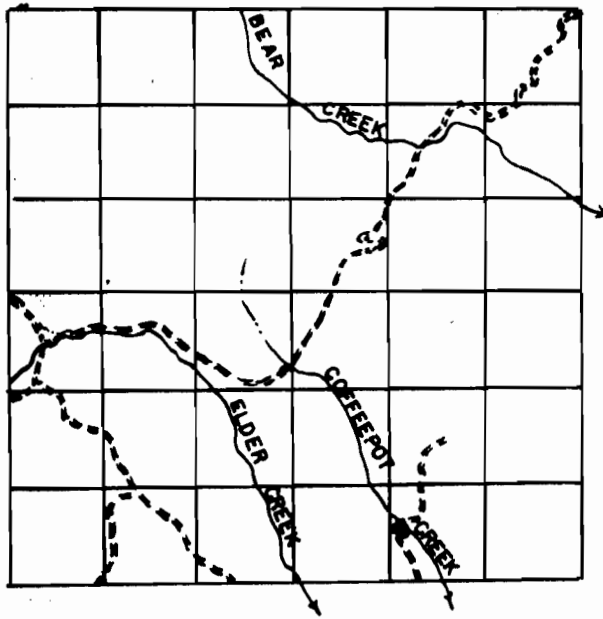

T. 34 S. R. 17 E.

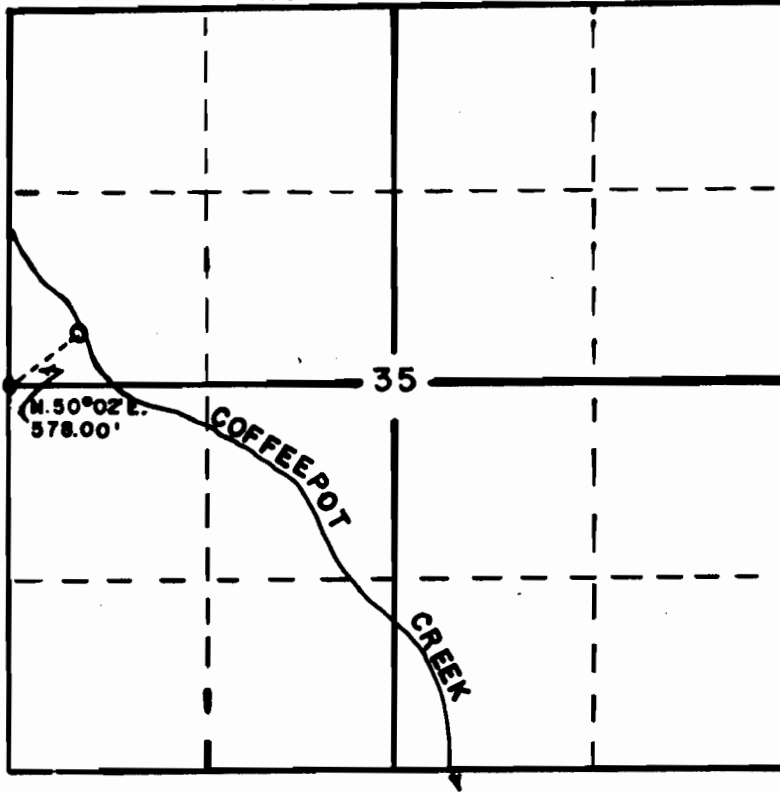

I, G. M. UPINGTON
 HEREBY CERTIFY
 DURING AN A
 SUPERVISION
 SHOWN ON T
 ARE 843.32
 T. 32 S., R. 1
 SECTION 22,
 OF W. 1/4 C

Applic
 Port
 STATE ENGINEER



TWA
V
L
K
SCALE
DEL.
TRAC