


T. 31S. R. 16E., W.M.

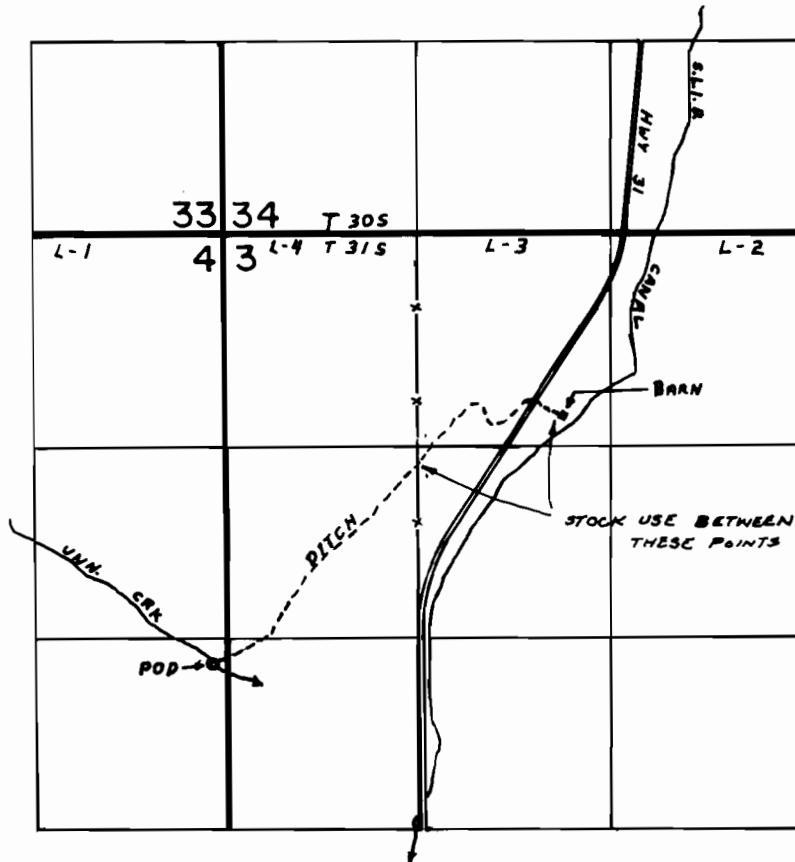

POD LOC 2960' S. & 100' W. FROM N.E. COR. SEC. 4

FINAL PROOF SURVEY UNDER

Application No. 53883... Permit No. 40204...
IN NAME OF

JEREMIAH O'LEARY

Surveyed JUL. 20, 1977, by D. M. NORBY