


T. 16S., R. 5W., W.M.

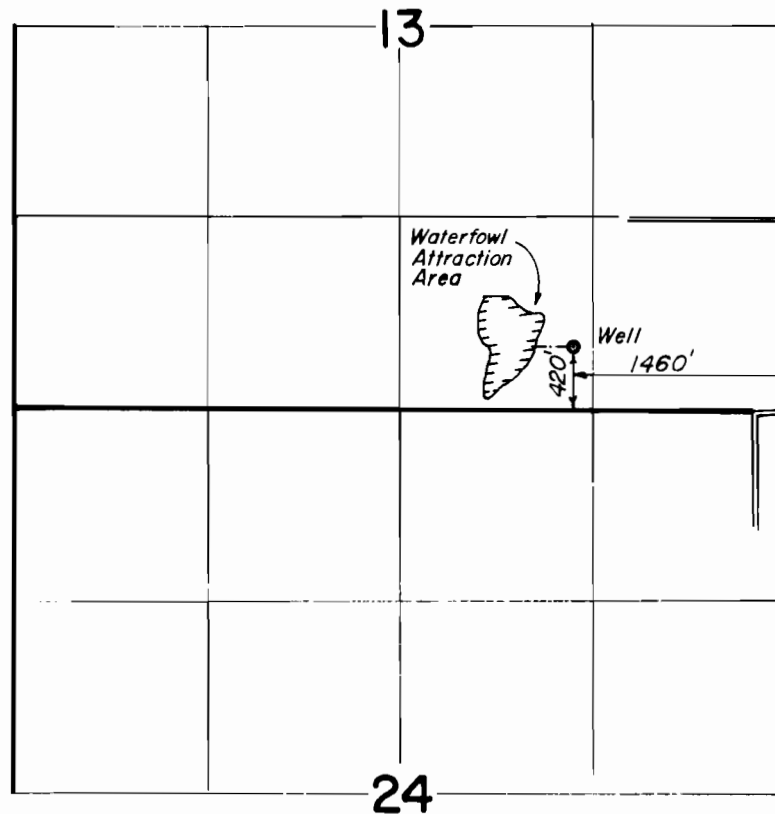

FINAL PROOF SURVEY
UNDER

Application No. G-3908 Permit No. G-3672
IN NAME OF

Estate of ORRIN P. SNELLSTROM

Surveyed MAY 11, 1978, by L. NUNN