


# T.16S. R.4W., W.M.

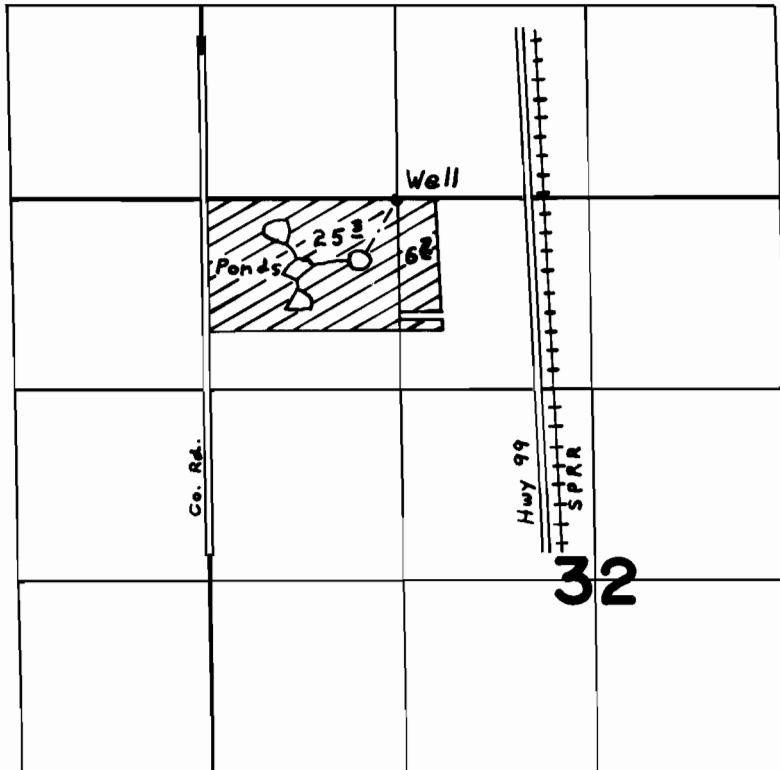

Well Loc. 10' S & 1320' E. From N.W. Cor. Sec. 32

## FINAL PROOF SURVEY UNDER

Application No. G-7176... Permit No. G-6612...  
IN NAME OF

COUNTRY PLACE GOLF COURSE...

Surveyed SEP. 13. 1978., by J.S. DONALDSON