


T.17S., R.1E., W.M.

SEC. 17

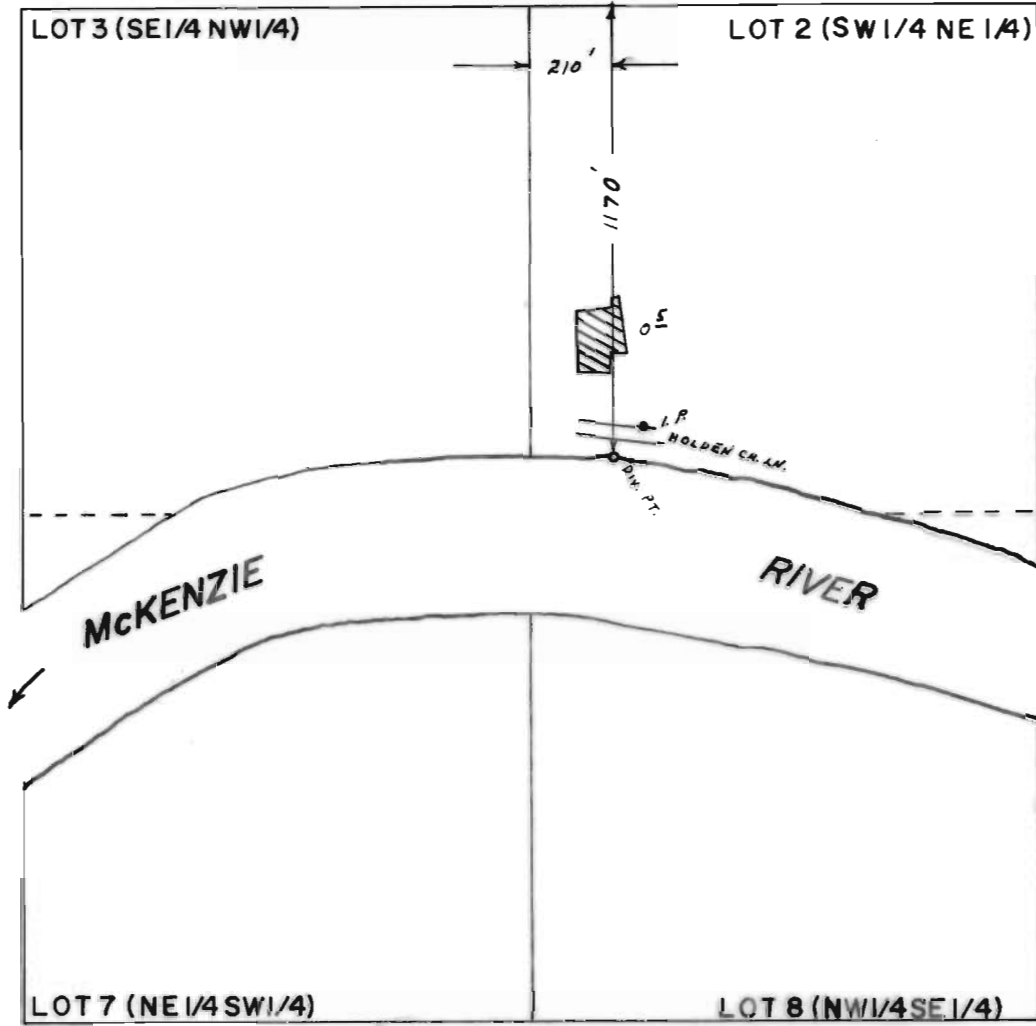

Scale 1" = 500'

FINAL PROOF SURVEY
UNDER

Application No. 50857... Permit No. 38398...
IN NAME OF

RAYMOND F. & BARBARA L. VALLIER

Surveyed Sept. 1, 1977, by L.H. MUNN