


T. 17S., R. 1E., W.M.

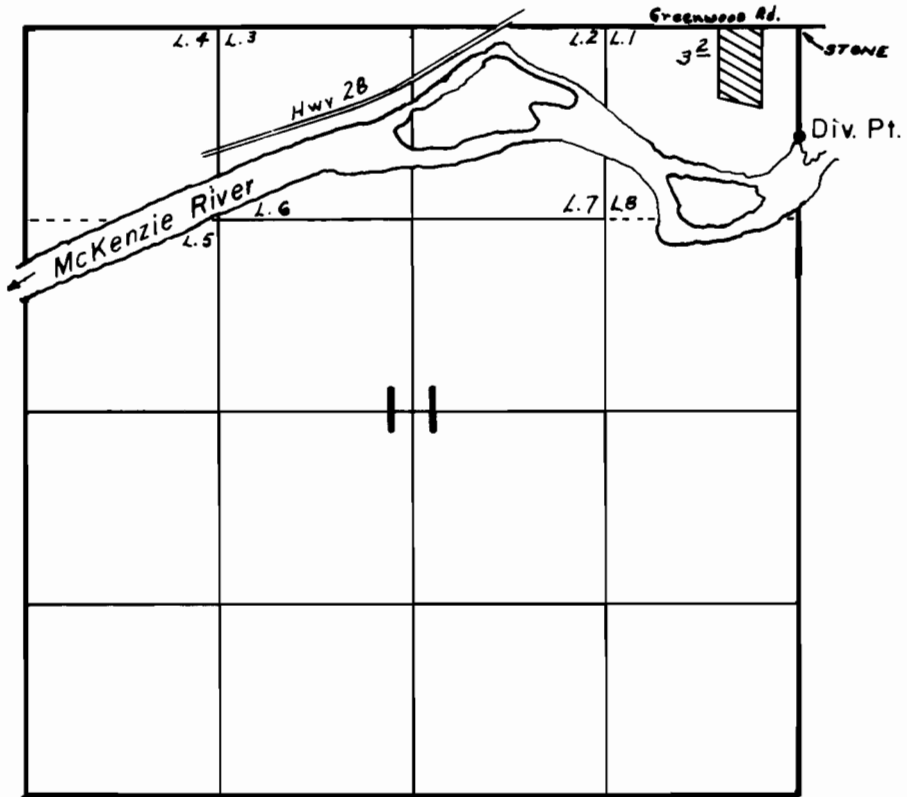

Div. pt. loc. 740' S. from NE cor. sec. 11

FINAL PROOF SURVEY UNDER

Application No. 53573... Permit No. 40087...
IN NAME OF

COLE - GUPTILL - MACY FARM

Surveyed AUG. 31. 1977, by L. H. NUNN.....