


T.17S. R.10W., W.M.

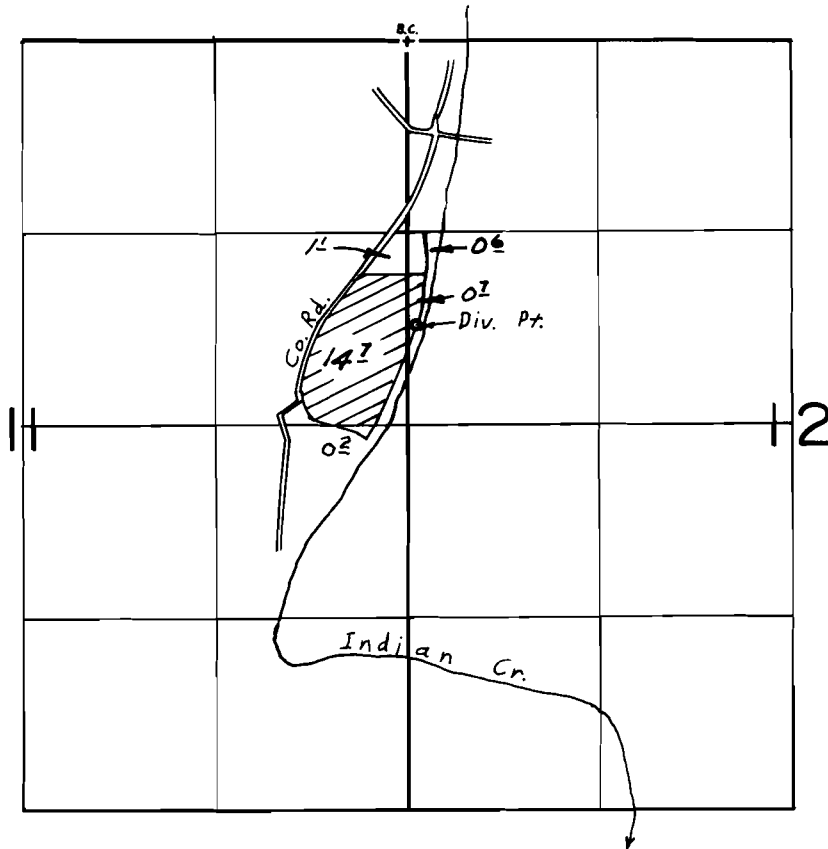

Div. Pt. Loc. 1950' S. & 50' E. From N.E. Cor. Sec. 11.

FINAL PROOF SURVEY UNDER

Application No. 53913..... Permit No. 40225...
IN NAME OF

.....LARRY BEERS.....

Surveyed AUG...25. 1977., by B.R.SUND.....