


T.8S.,R.10W.,W.M.

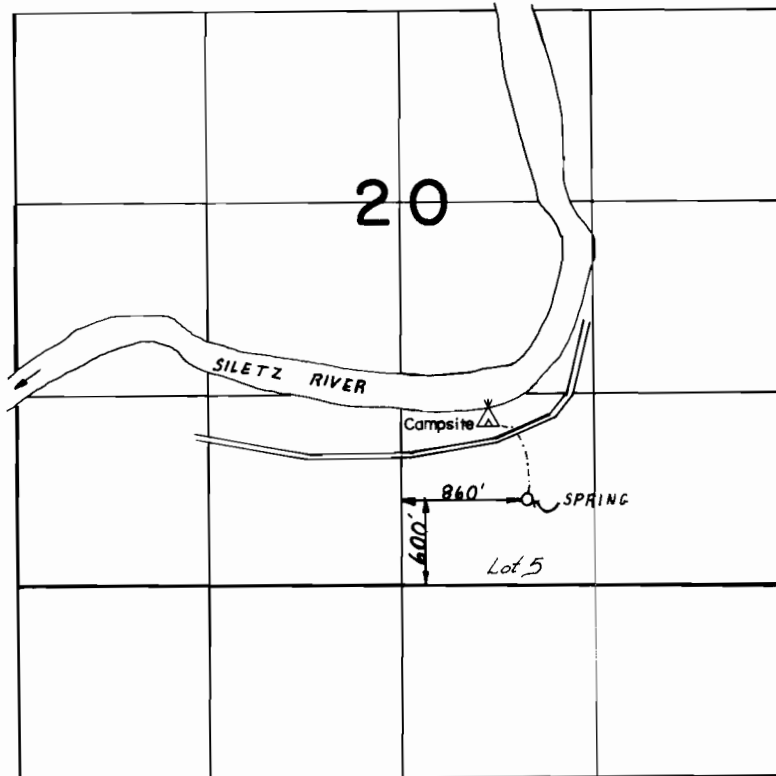

FINAL PROOF SURVEY
UNDER

Application No. 42995 Permit No. 32124
IN NAME OF

VALDEMAR & GENEVIEVE NELSON

Surveyed JULY 2 1976, by C.R. KING
Inspected May 17 1978, by L.H. Nunn