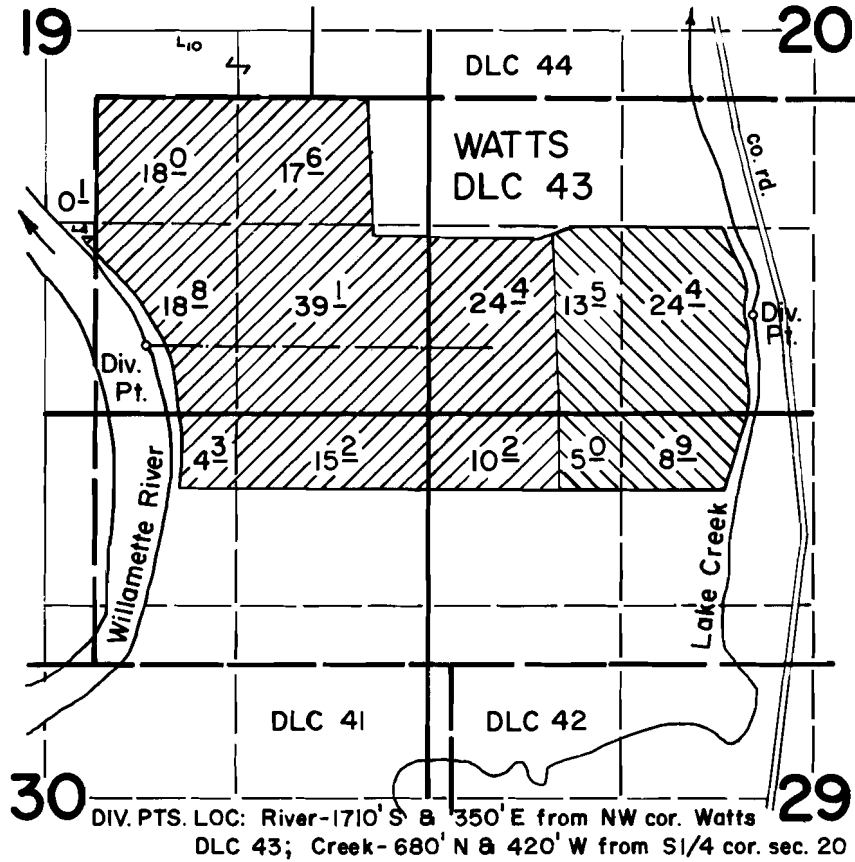

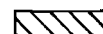


T.13S., R.4W., W.M.



 Willamette River
 Lake Creek

FINAL PROOF SURVEY UNDER

Application No. 50455 Permit No. 38108
IN NAME OF

JERRY A. DYKSTERHUIS

Surveyed Oct. 19 1976, by D. Norby