


T.15S. R.4W. W.M.

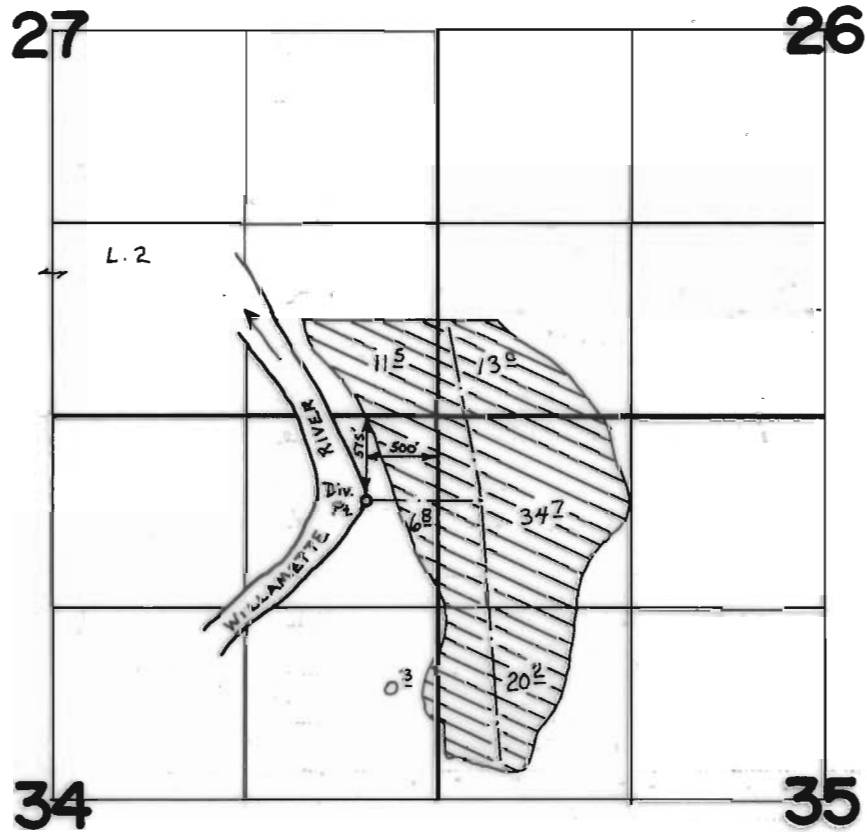

FINAL PROOF SURVEY
UNDER

Application No. 52780 Permit No. 37777
IN NAME OF

BOWERS DISTILLERY, INC.

Surveyed NOV. 8 1977, by J. S. DONALDSON