


T.10S.R.2W.W.M.

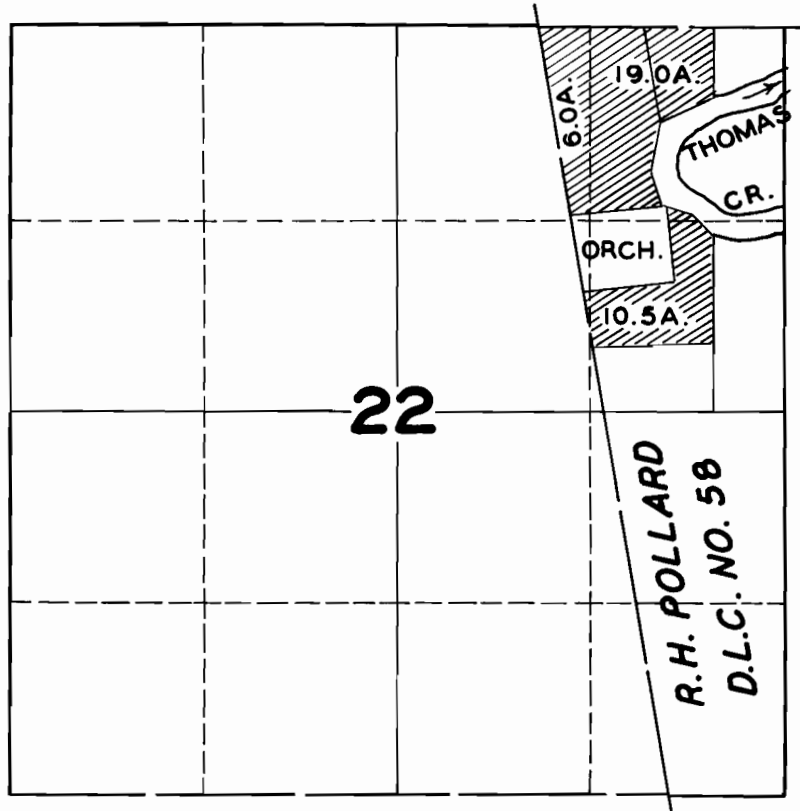

FINAL PROOF SURVEY

UNDER


Application No. 19079 Permit No. 14674


IN NAME OF


J. B. HODGES

Surveyed APR. 1 1949, by JAS. E. BUNNELL

T.10S.R.2W.W.M.

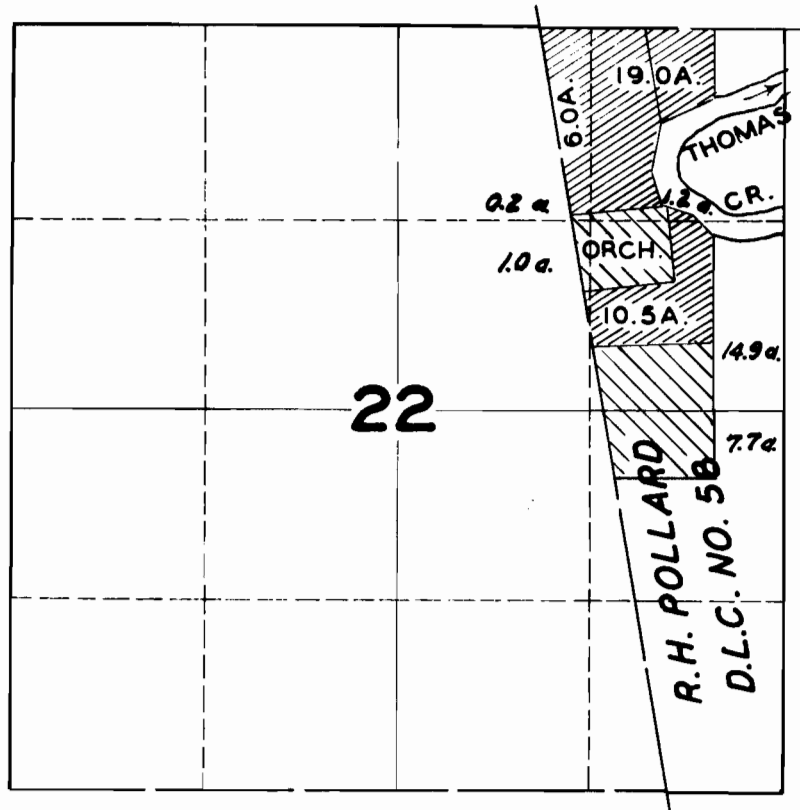

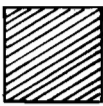 Per. No.
14674

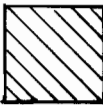 APP. No.
27208
25 a.
Per. No.
21393

FINAL PROOF SURVEY

UNDER

Application No. **19079** Permit No. **14674**

IN NAME OF

J. B. HODGES

Surveyed **APR. 1** 1949, by **JAS. E. BUNNELL**