


GENERAL MAP  
 OF  
**VALE OREGON**  
 IRRIGATION PROJECT  
 AND  
**WARMSPRINGS**  
 IRRIGATION DISTRICT  
 JAN. 1928 SCALE 1 IN = 1 MILE

**LEGEND**

- PROPOSED CANAL
- - - - - WARMSPRINGS IR. DIST. CANALS
- WARMSPRINGS IR. DIST. DRAINS
- ⊕ DIVERSION DAMS
- RAILROADS
- STATE HIGHWAYS
- TRANSMISSION LINES
- STREAMS AND BRIDGES
- ROADS
- WARMSPRINGS IR. DIST. BOUNDARY
- VALE OREGON IR. DIST. BOUNDARY

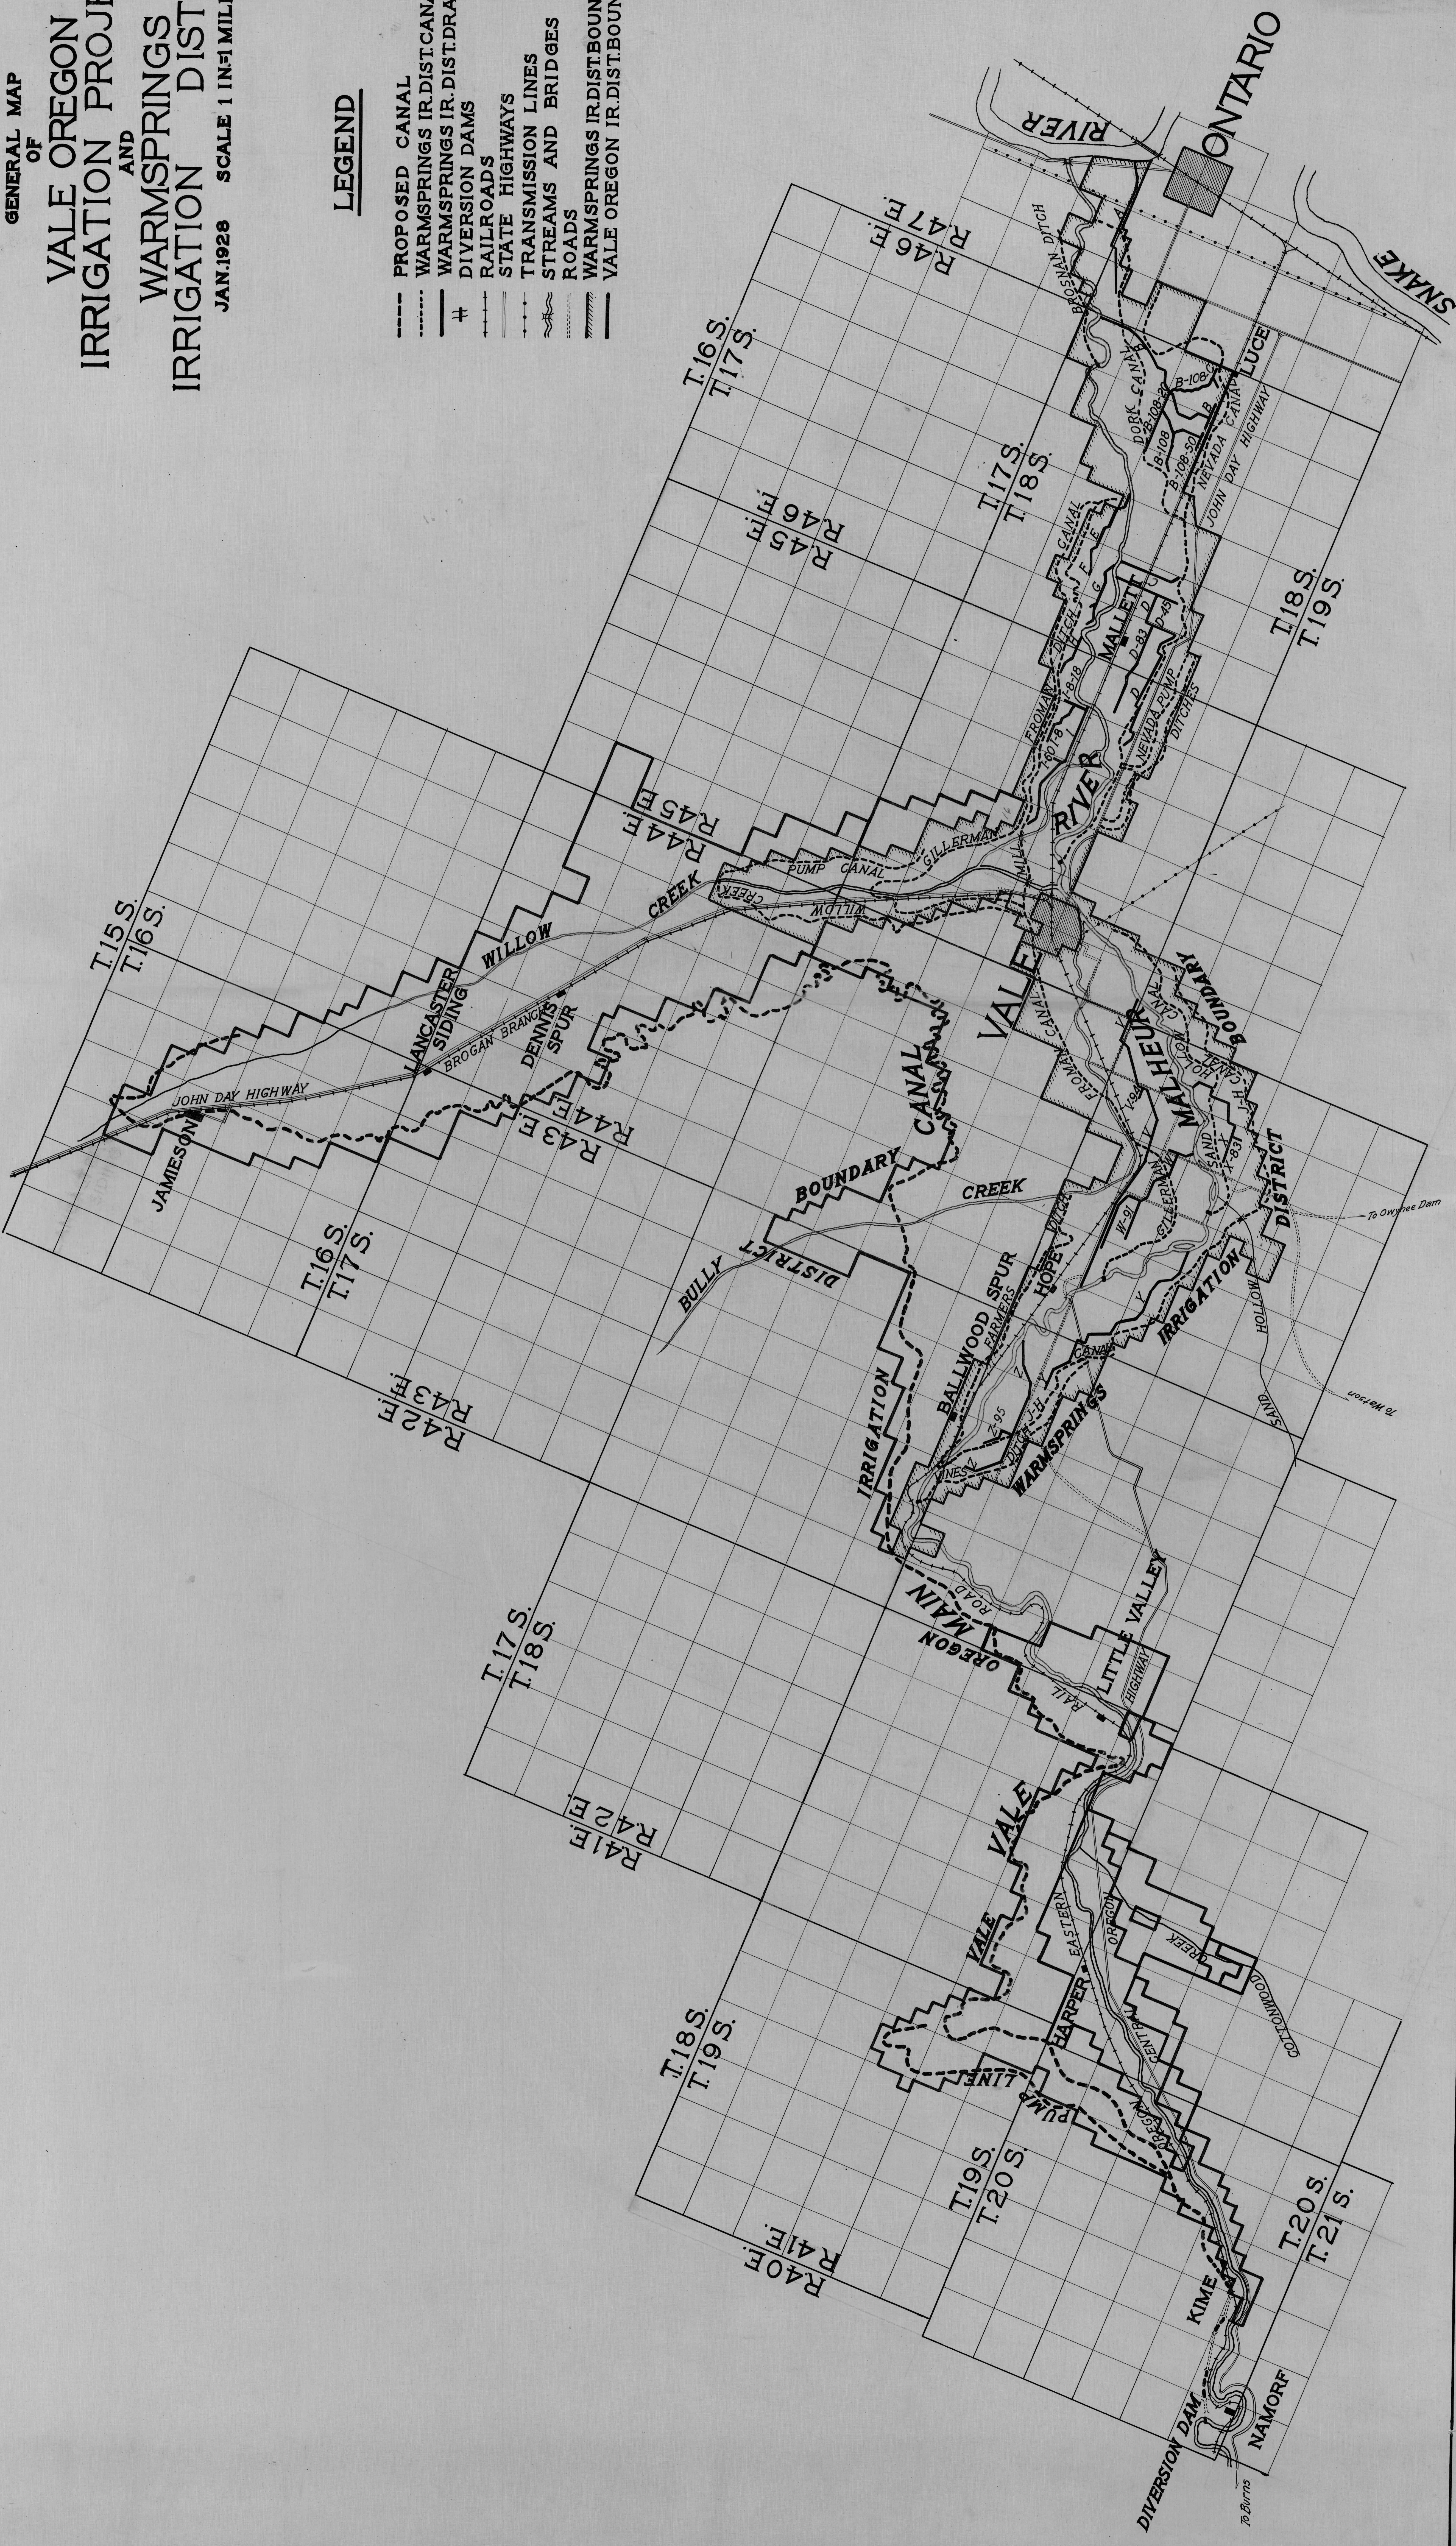

ONTARIO

SNAKE RIVER

VALE RIVER

VALE CANAL

BOUNDARY

CREEK

IRRIGATION DISTRICT

WARMSPRINGS

VALE

VALE

VALE

VALE

VALE

VALE

T. 15 S.  
T. 16 S.

T. 16 S.  
T. 17 S.

T. 17 S.  
T. 18 S.

T. 18 S.  
T. 19 S.

T. 19 S.  
T. 20 S.

T. 20 S.  
T. 21 S.

R. 45 E.  
R. 46 E.

R. 46 E.  
R. 47 E.

T. 18 S.  
T. 19 S.

R. 42 E.  
R. 43 E.

R. 42 E.  
R. 43 E.

R. 45 E.  
R. 46 E.

R. 46 E.  
R. 47 E.

JAMESON

LANCASTER SIDING

WILLOW

CREEK











JOHN DAY HIGHWAY

BROGAN BRANCH

DENNIS SPUR

PUMP CANAL

GILLERMAN

































T.17S., R.44E.W.M.

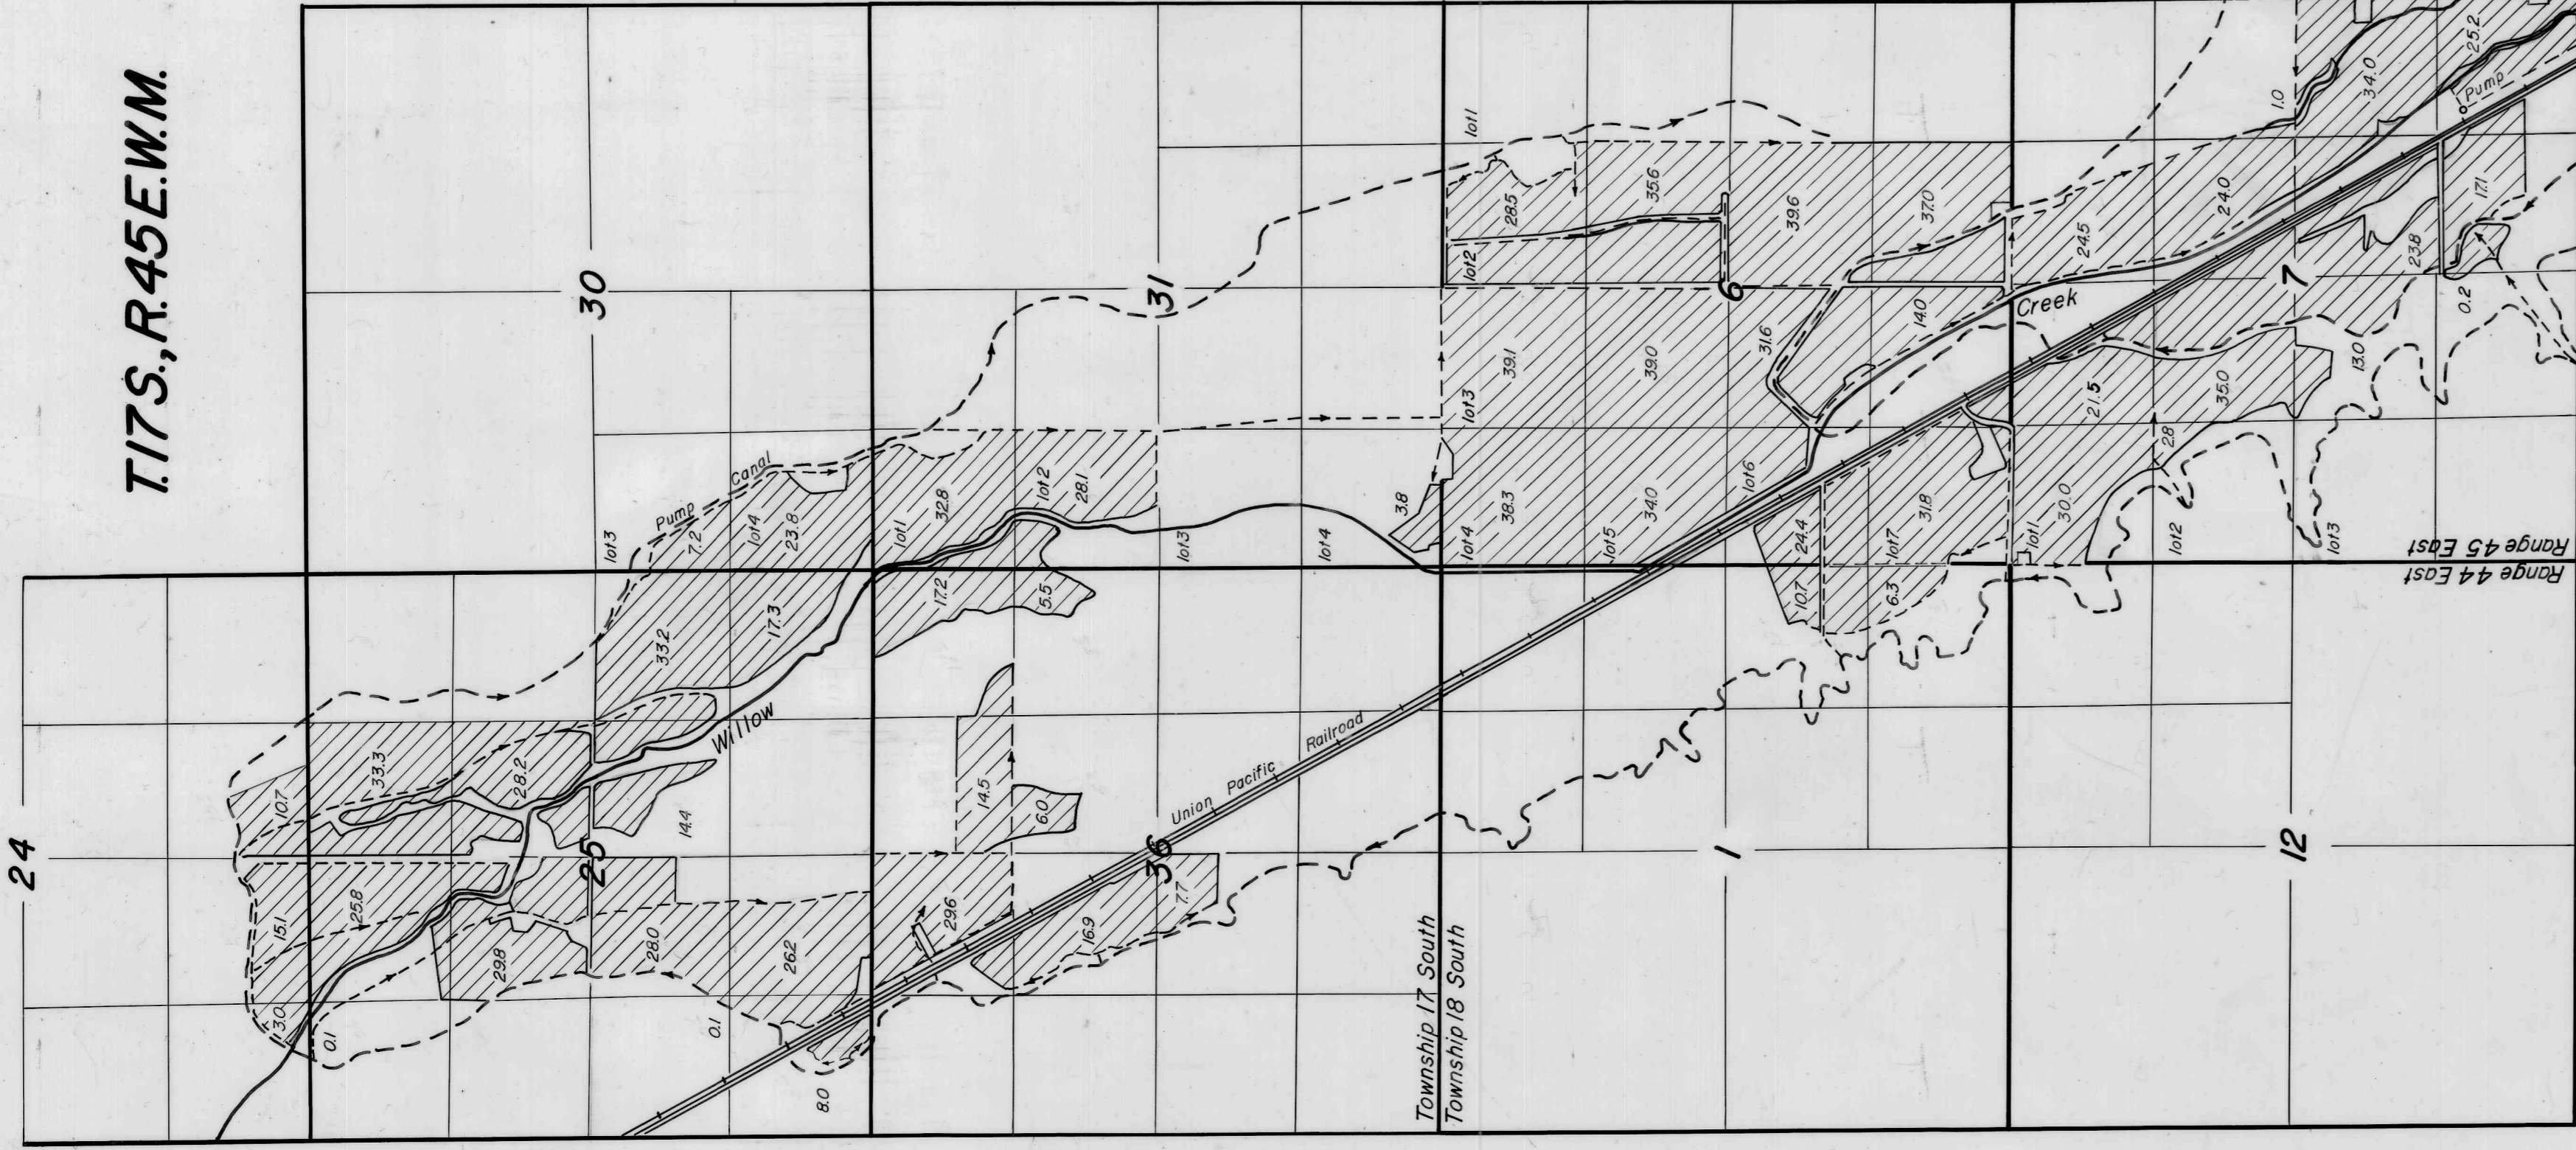


T.17S., R.45E.W.M.


T.18S., R.45E.W.M.

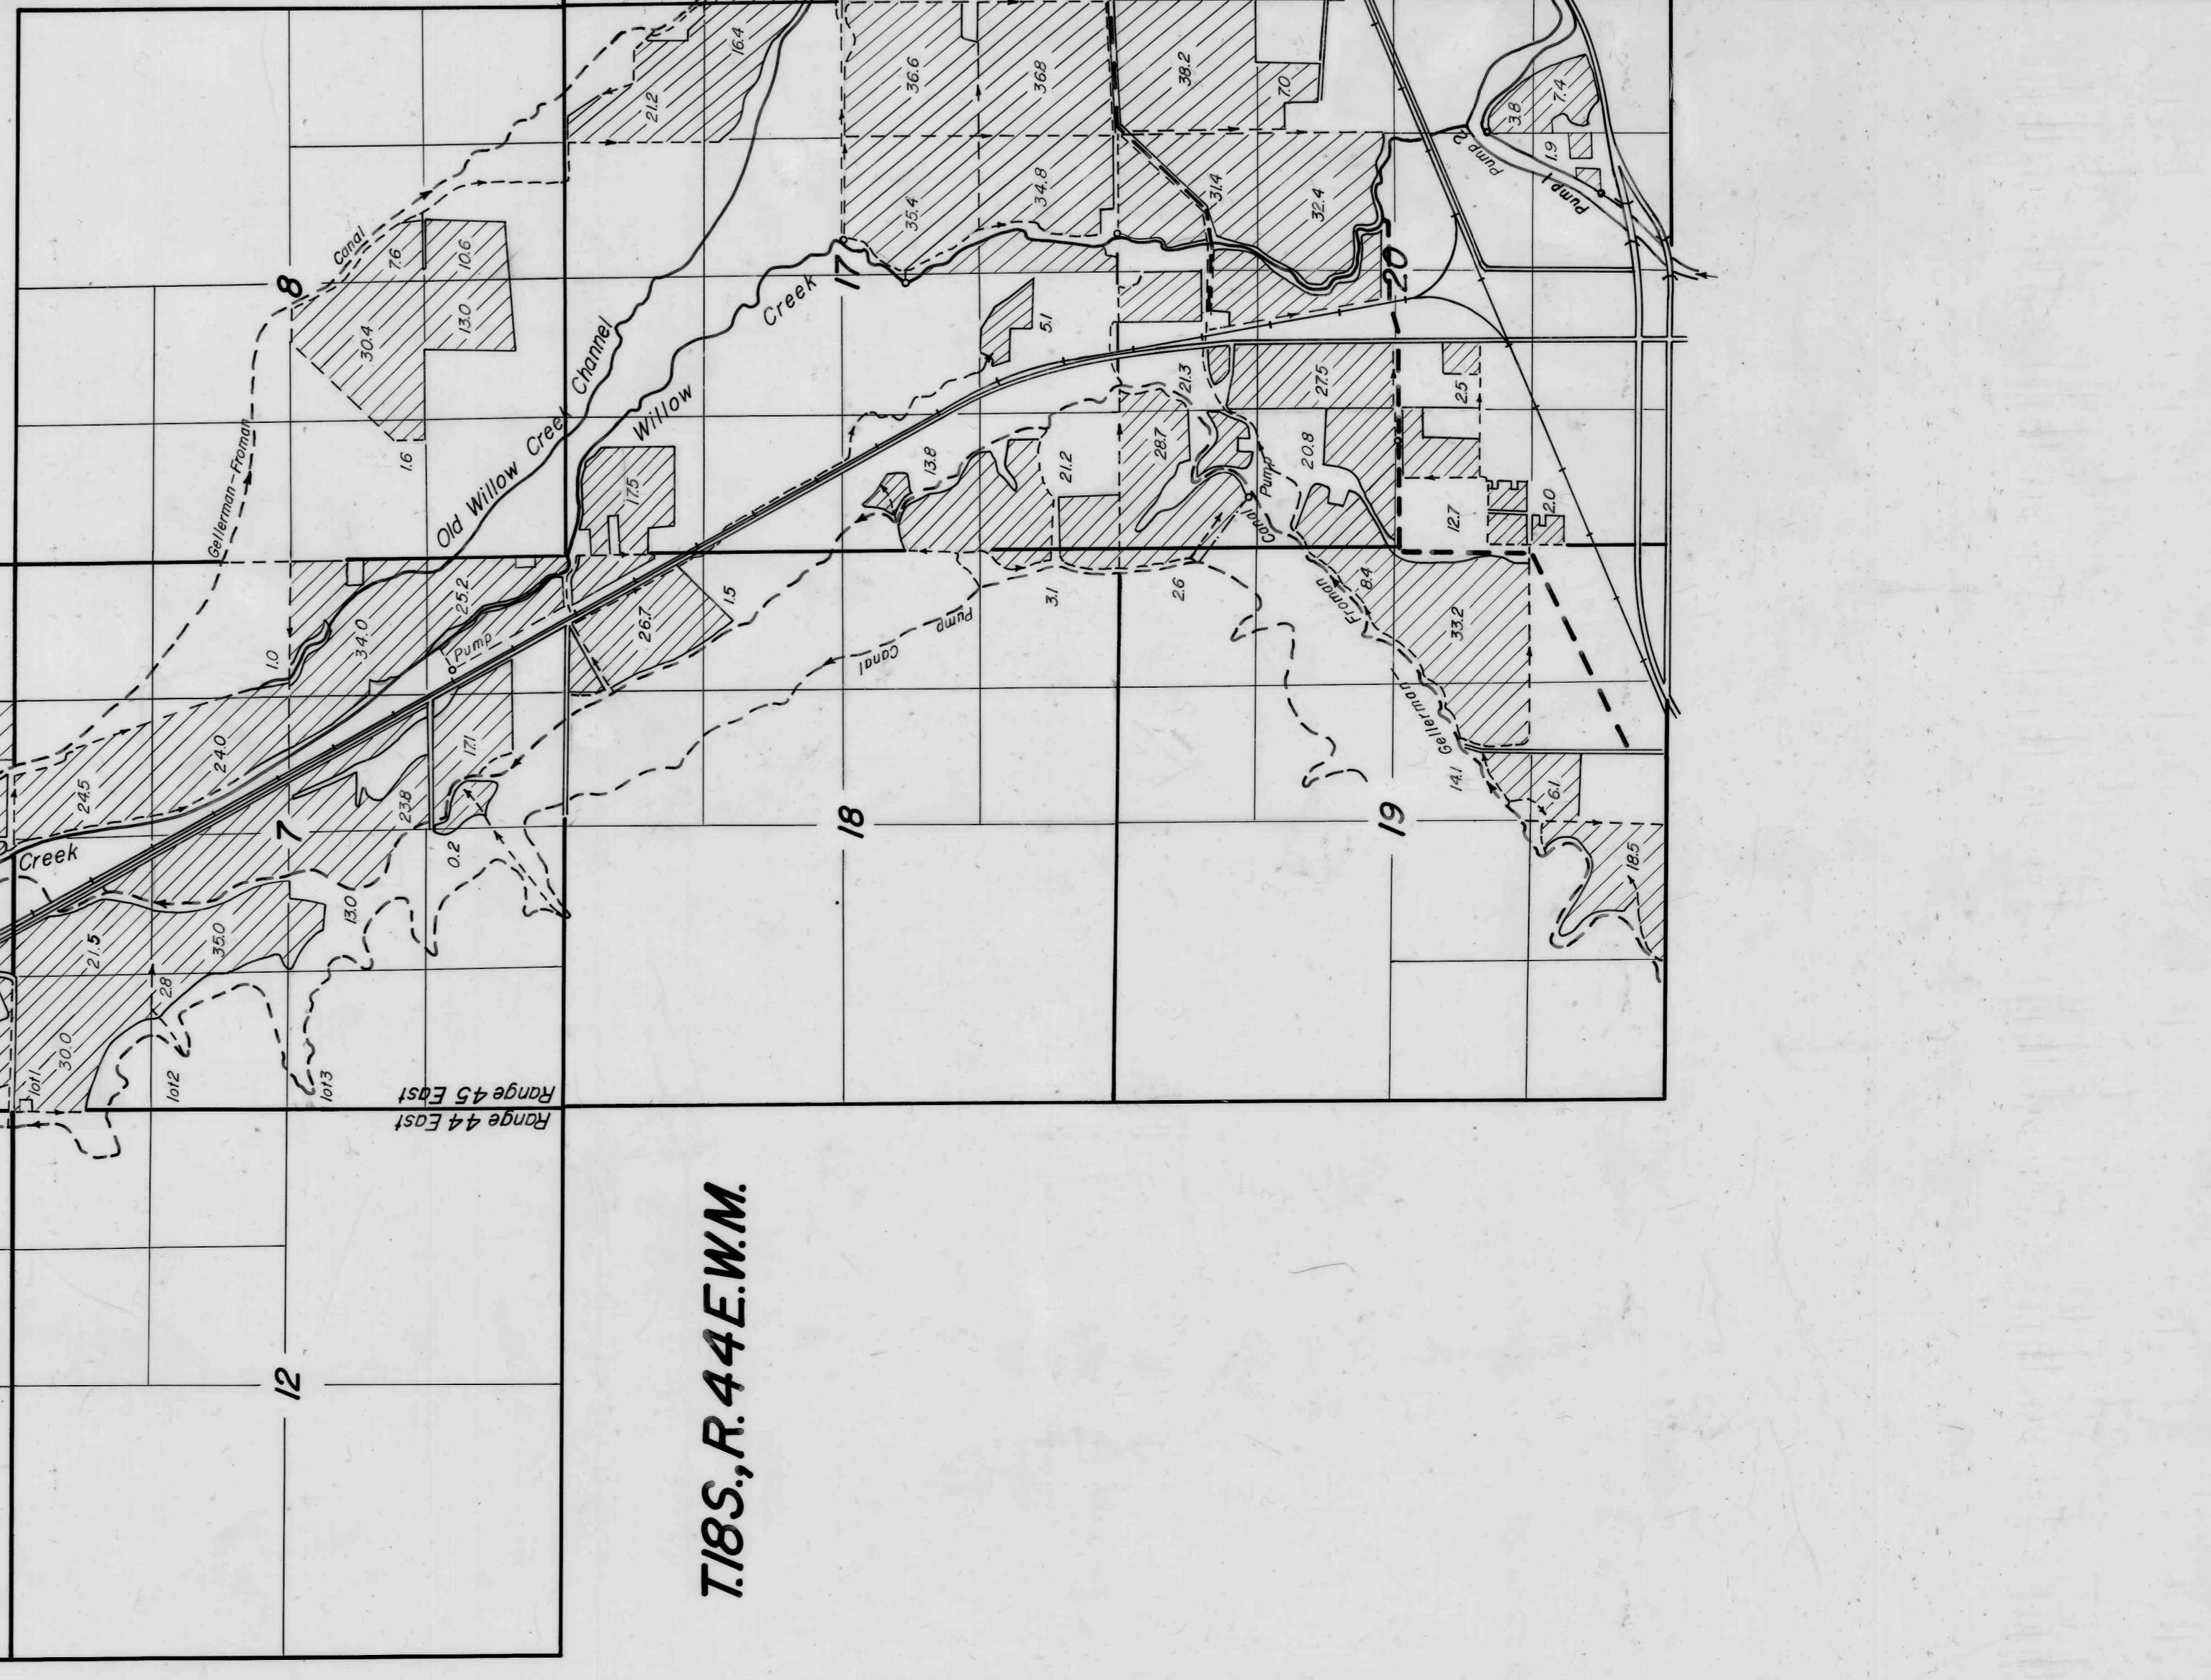


T.18S., R.46E.W.M.

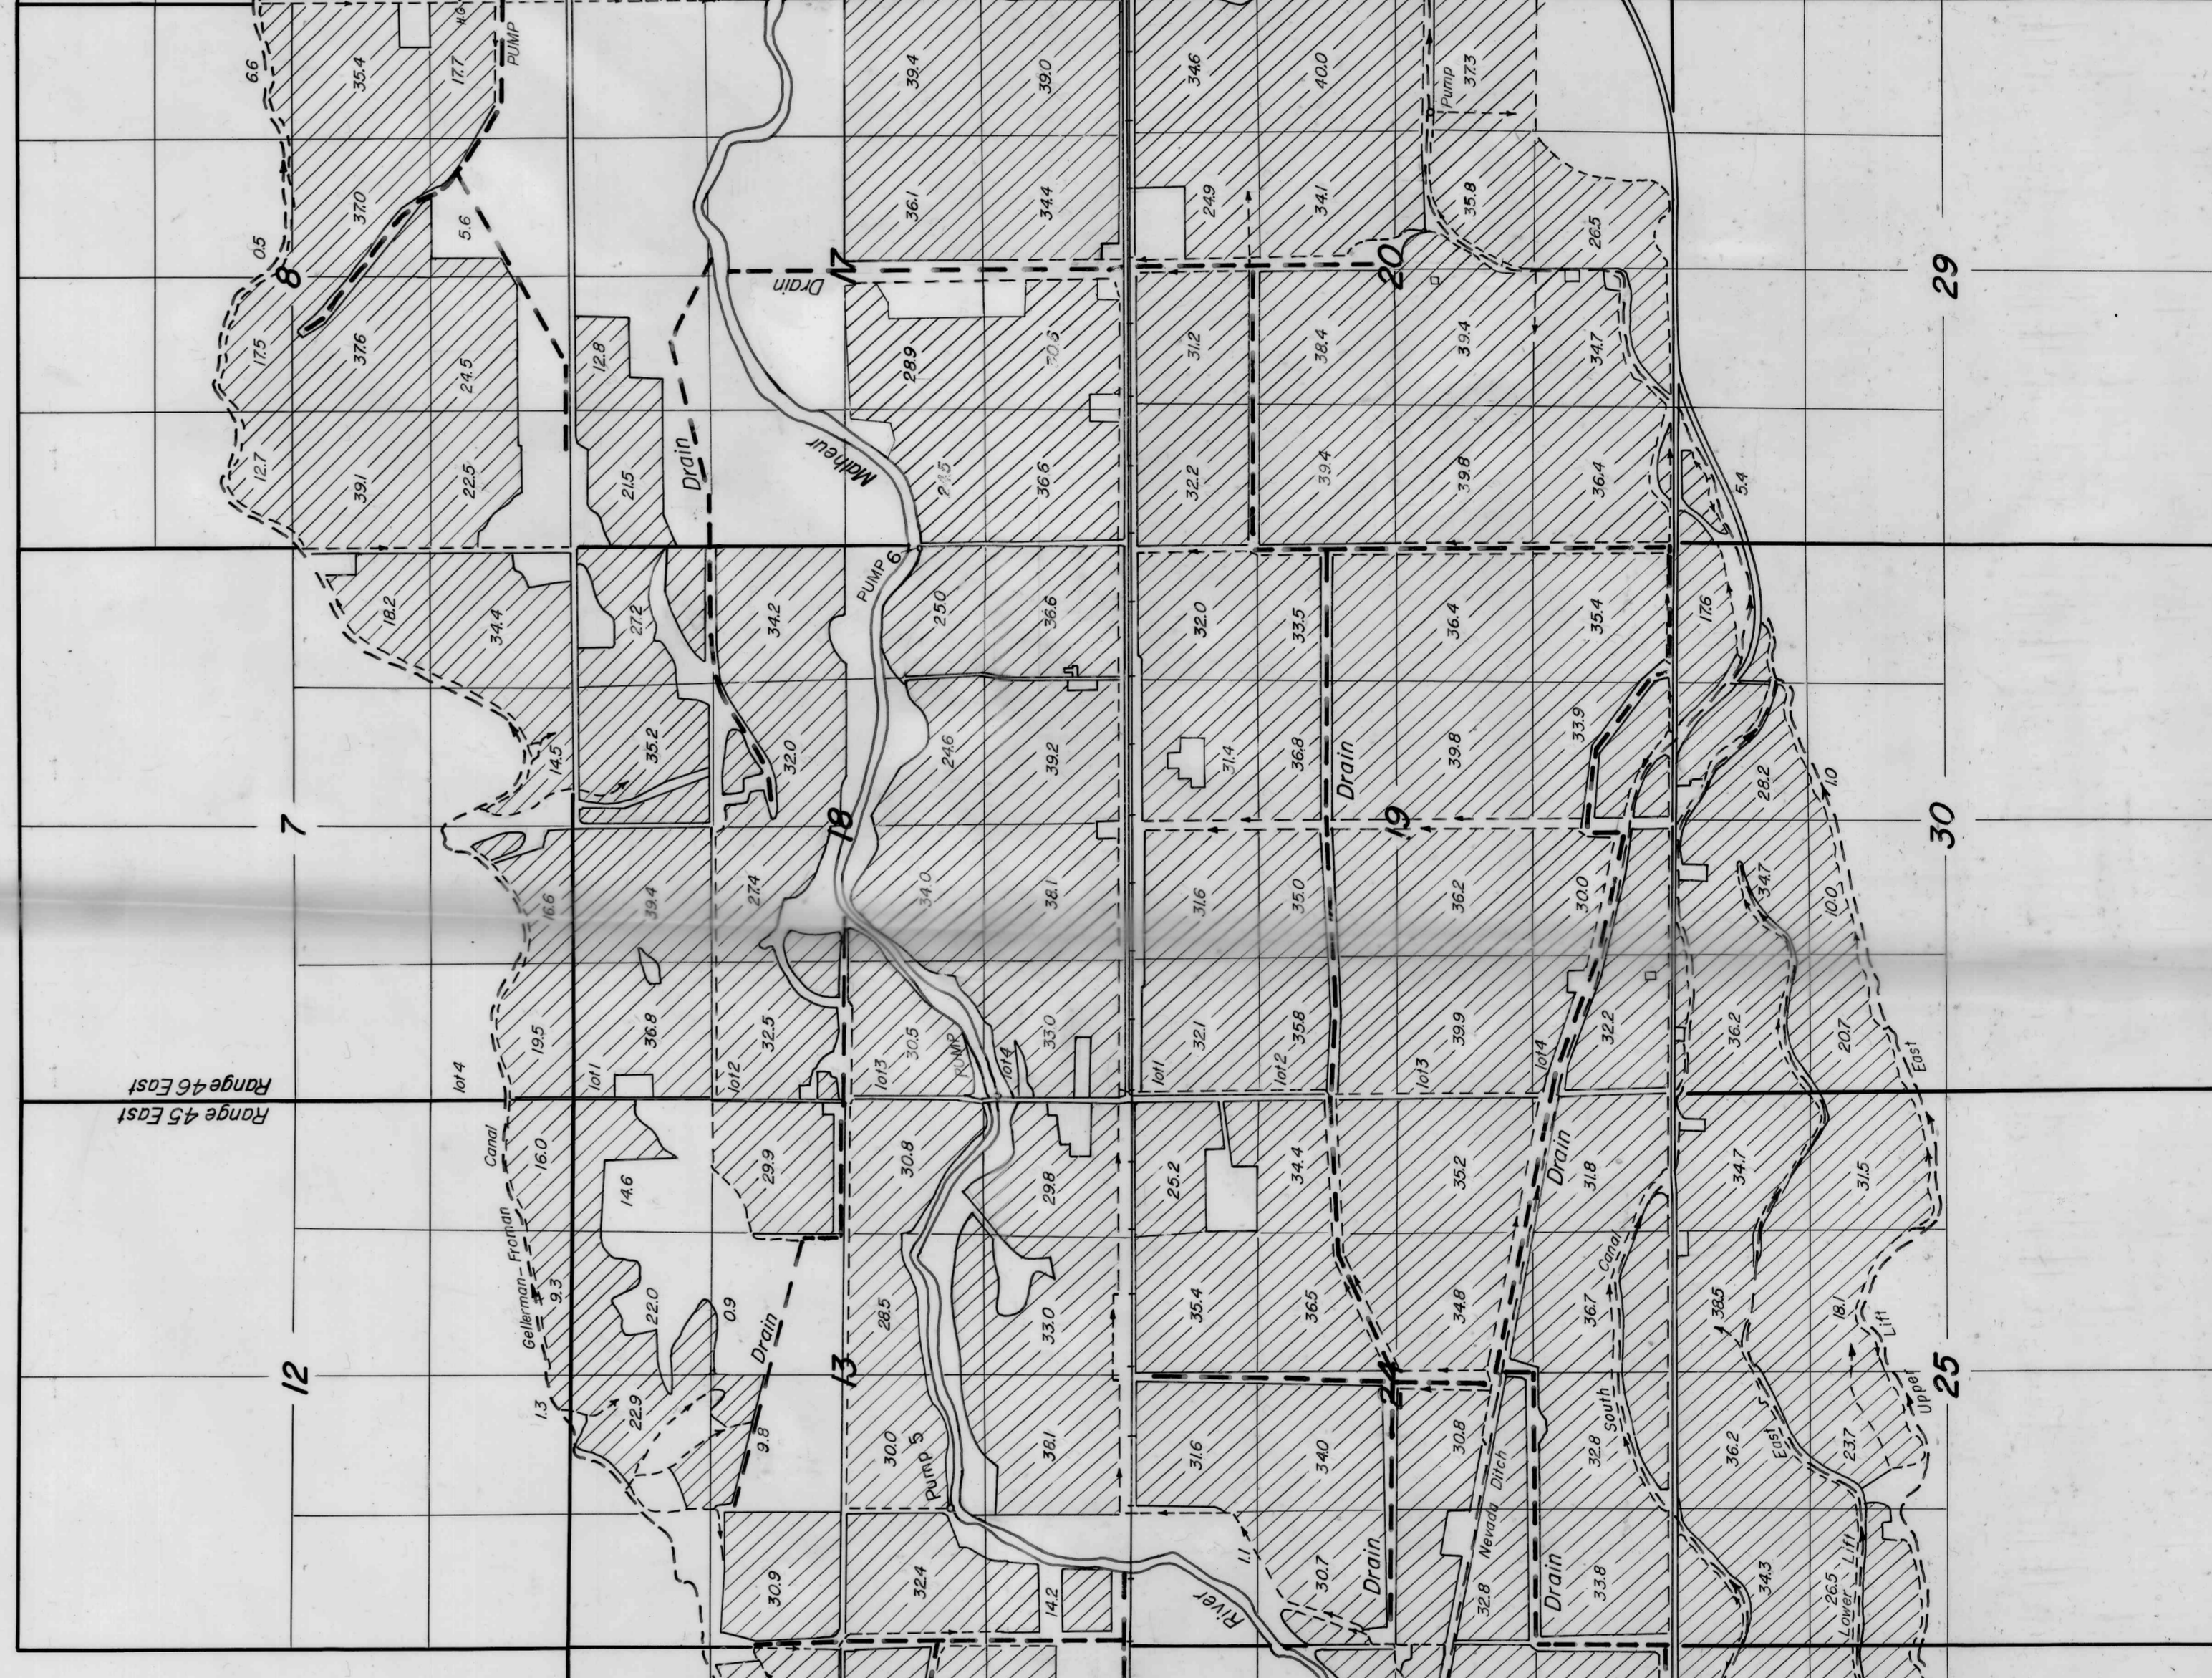

T.18S., R.47E.W.M.

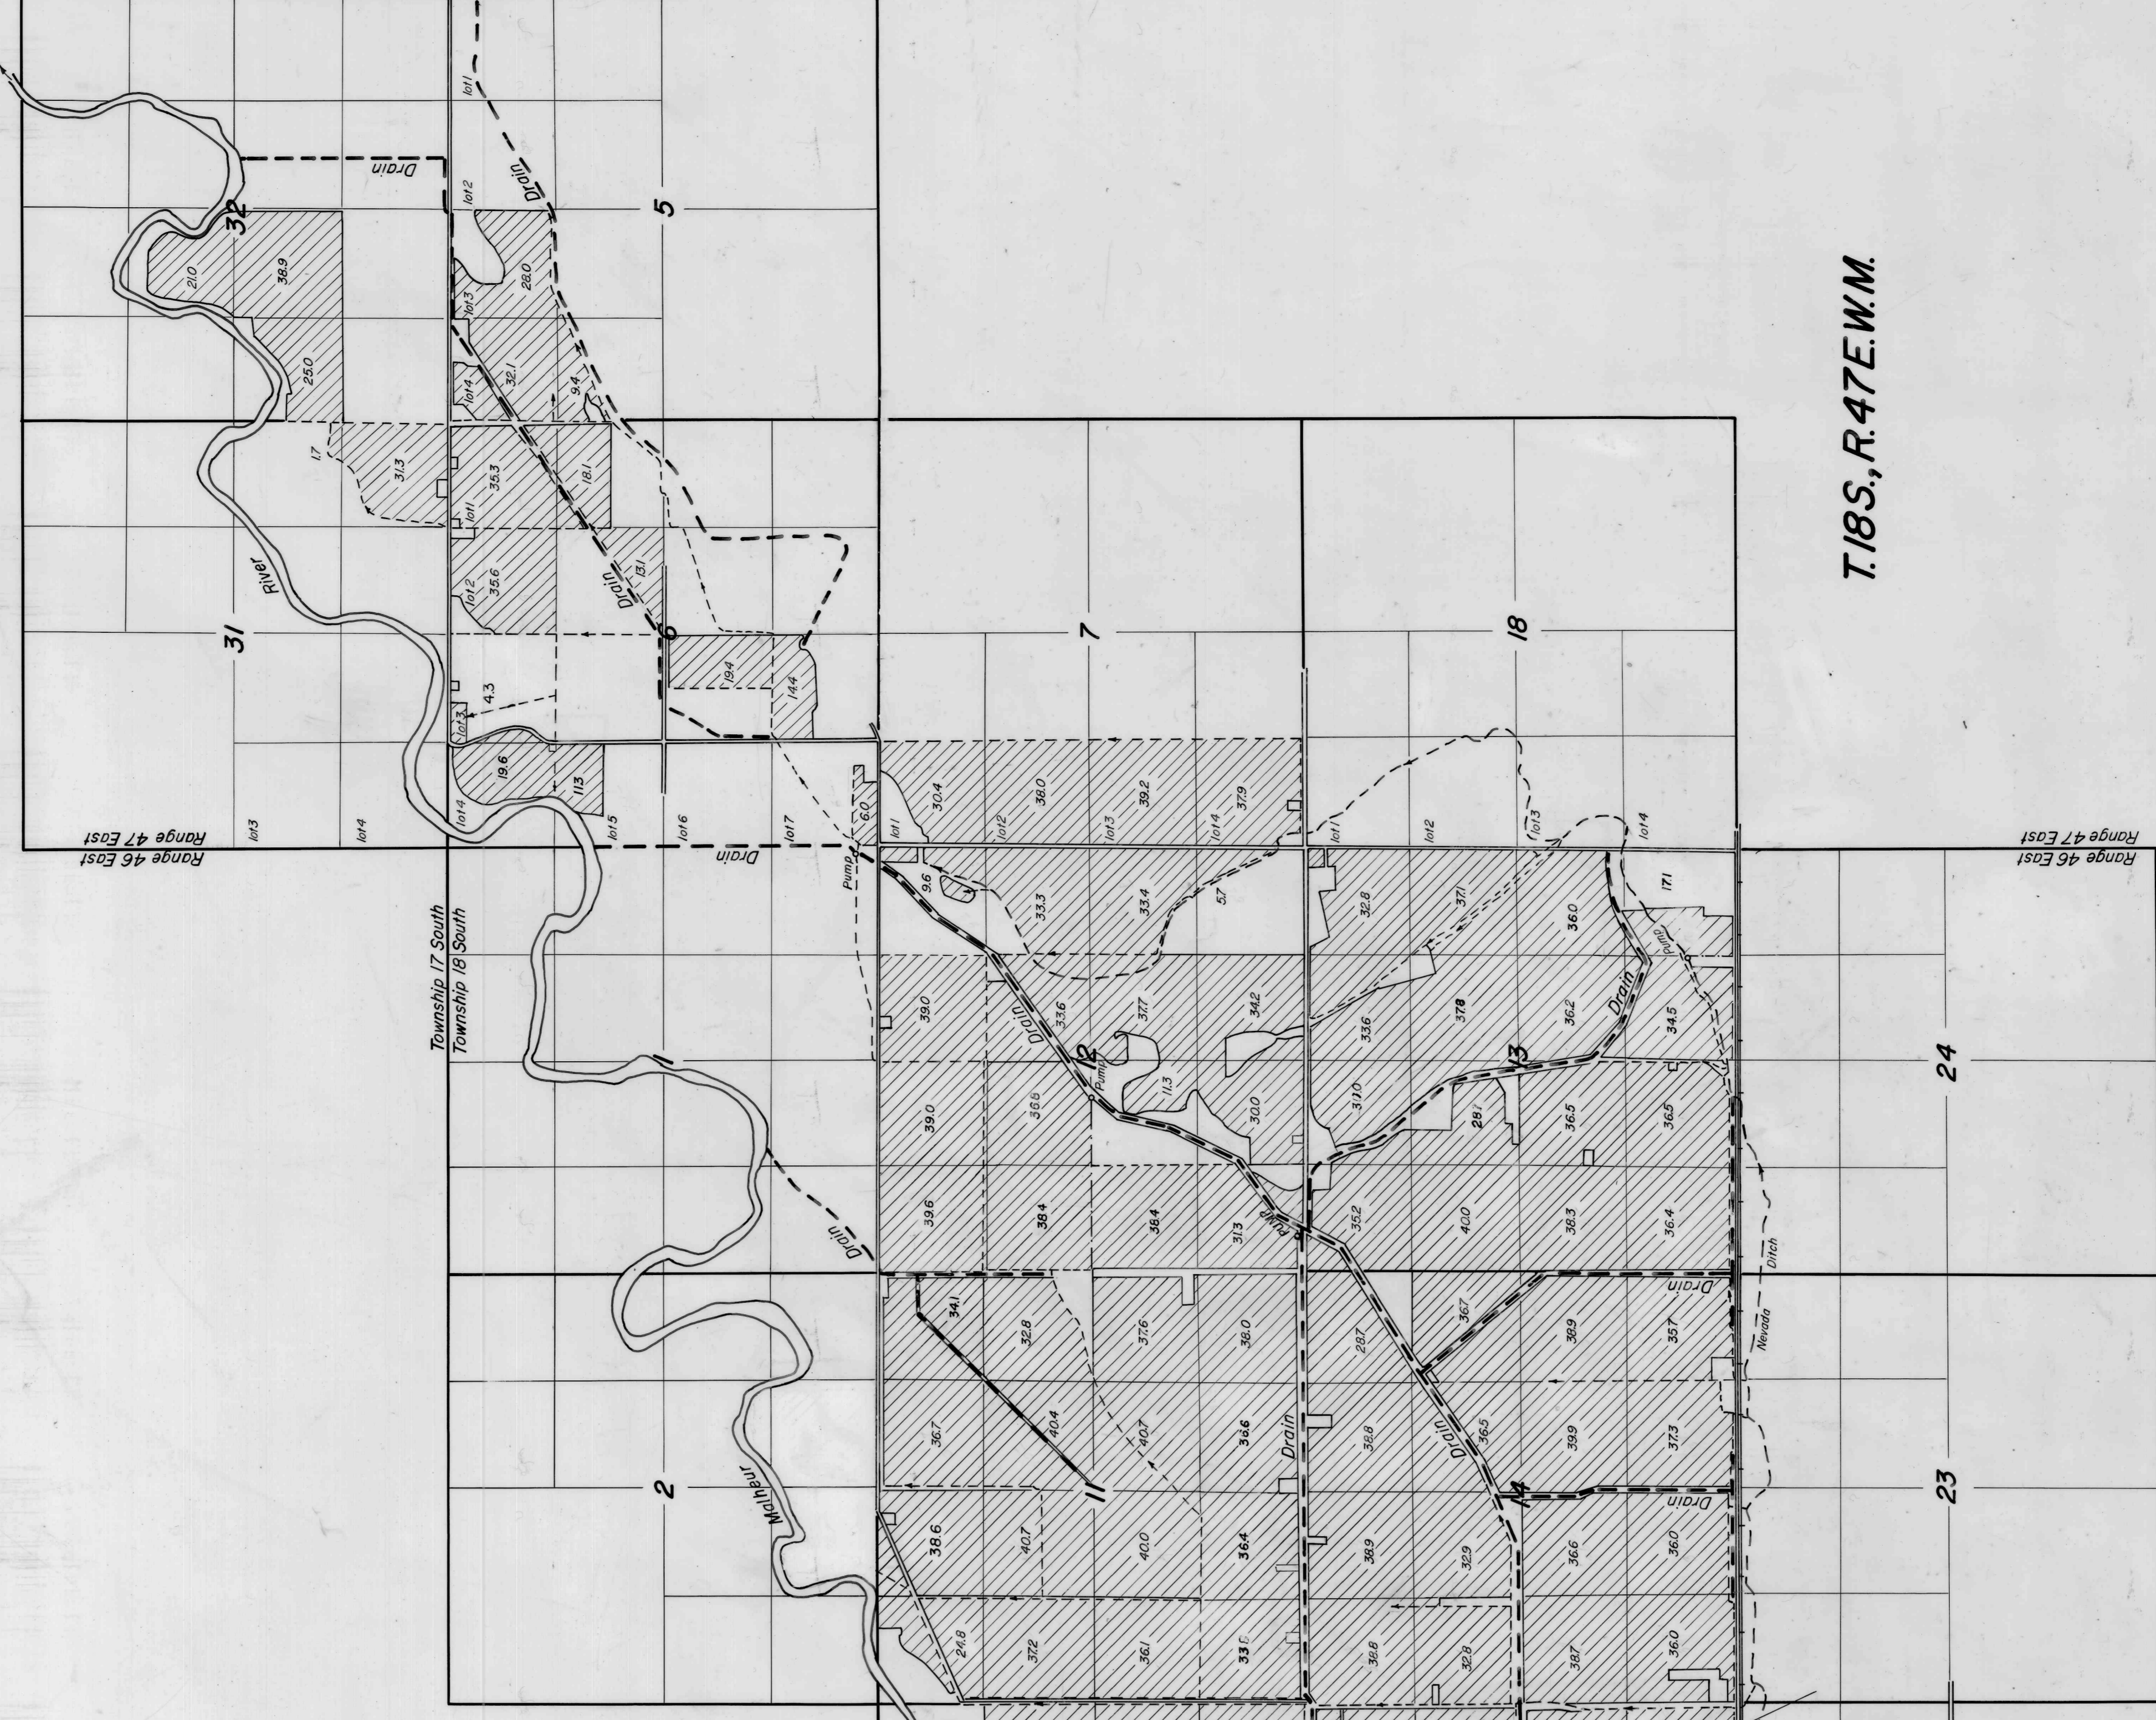

T.17S., R.47E.W.M.

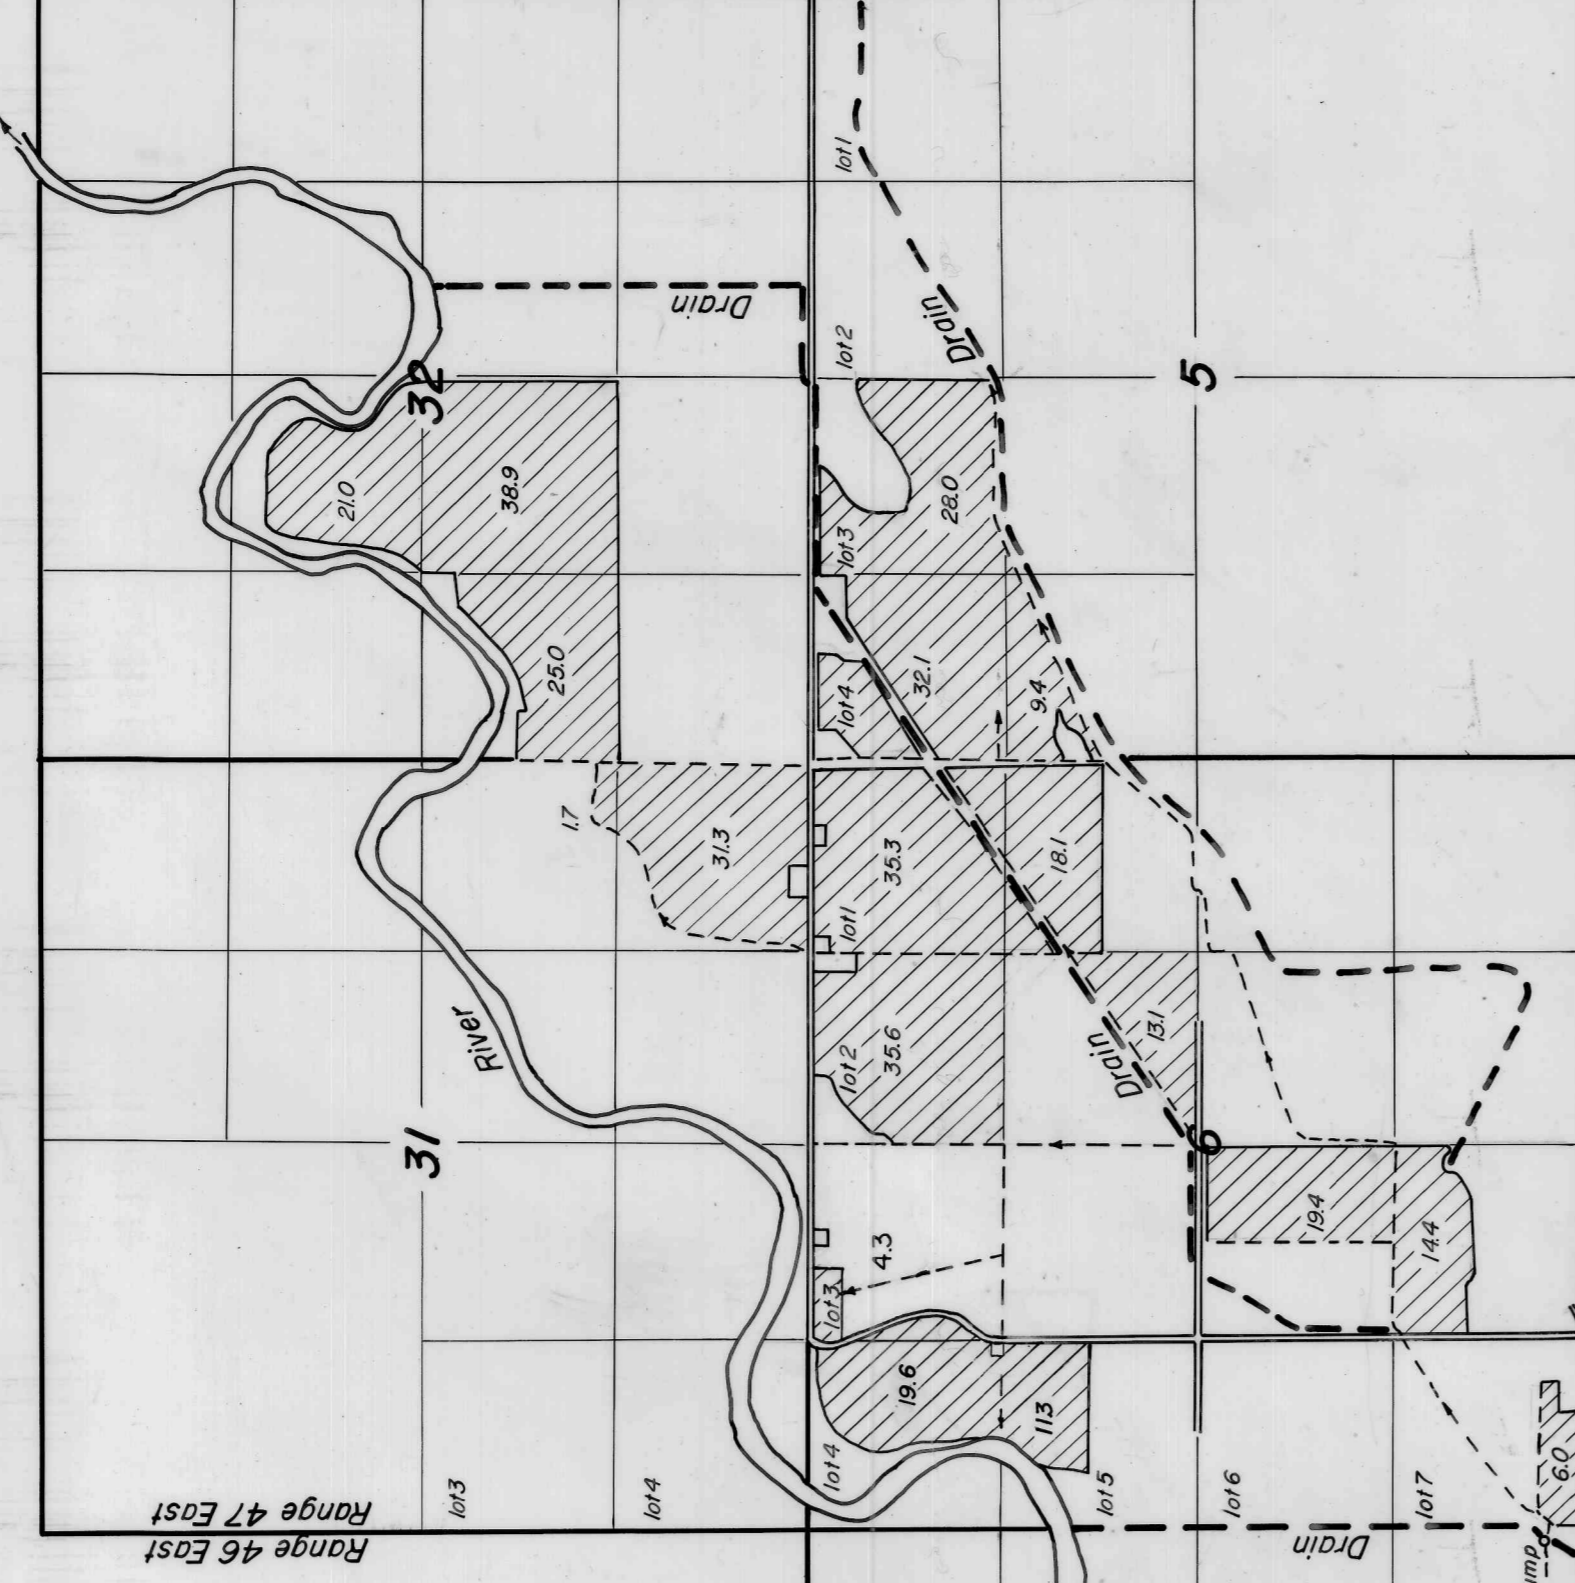


**WARMSPRINGS IRRIGATION DISTRICT**  
 Mapped By The OREGON STATE ENGINEER

For Final Proof Survey  
 Under  
 Application Numbers 4752 & 84723, Permit Numbers 4203 & 1647  
 Transfer Numbers 2856 & 2855  
 0 1 2 3 4 5  
 Miles  
 Sheet 2 of 2



213

T.18S., R.45E.W.M.

 

T.18S., R.43E.W.M.

T.18S., R.44E.W.M.

T.19S., R.43E.W.M.

T.19S., R.45E.W.M.

T.19S., R.44E.W.M.

WARMSPRINGS IRRIGATION DISTRICT

Mapped By The OREGON STATE ENGINEER

For Final Proof Survey

Under

Application Numbers 4752 & 19423, Permit Numbers 4303 & 8547

Transfer Numbers 2824 & 2825

Scale 1" = 100' 1/2"

Sheet 1 of 2