


T.18S., R.47E., W.M.

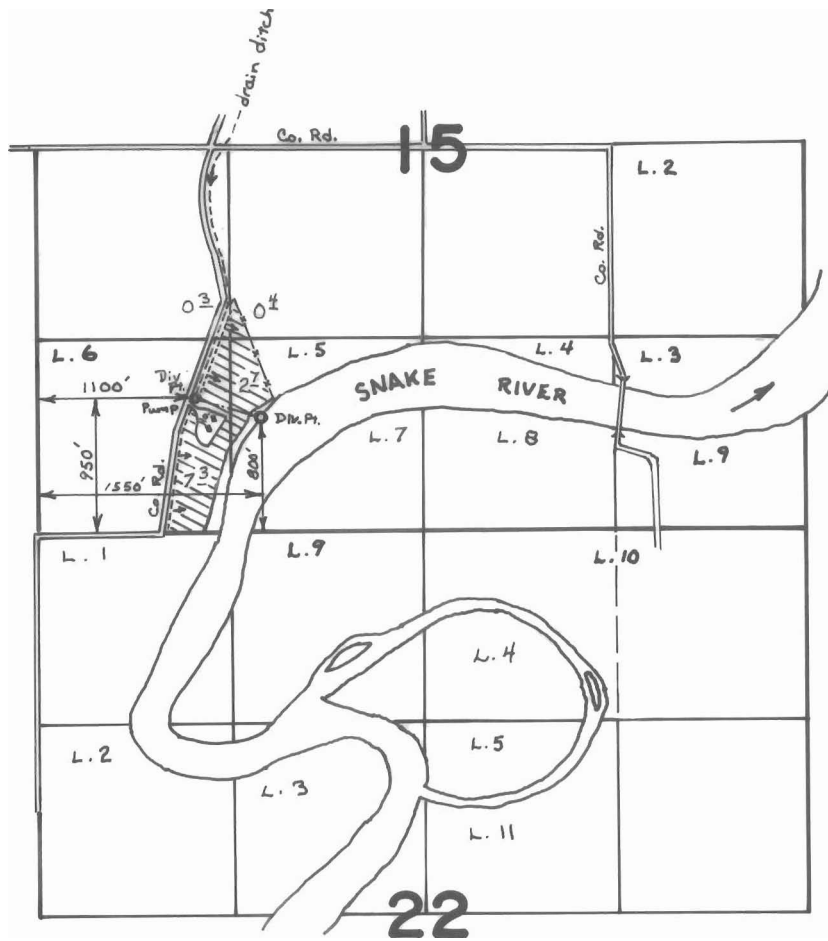

FINAL PROOF SURVEY UNDER

Application No. 49539.. Permit No. 40783..
IN NAME OF

..WILLIAM E. & MARY GAIL BLACKABY..

Surveyed .OCT..17.. 1977., by J.S.DONALDSON