


# T.6S. R.3W., W.M.

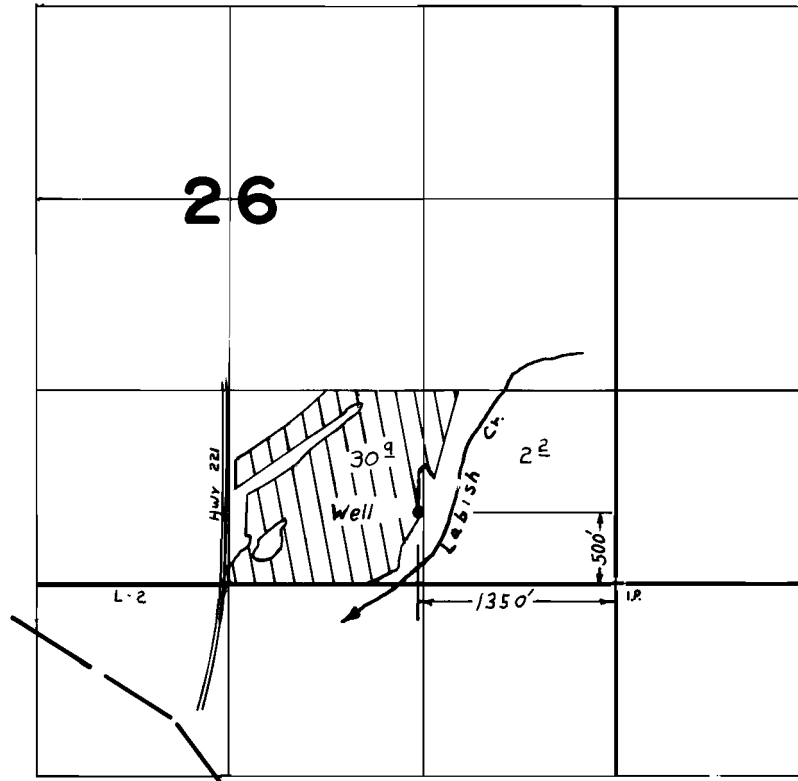

## FINAL PROOF SURVEY UNDER

Application No. G-5597.. Permit No. G-5450..  
IN NAME OF

.....ALFRED R. NOLAN.....

Surveyed AUG. 9. 19.7.7, by B. R. SUND.....