


T. 6S. R. 2W. W.M.

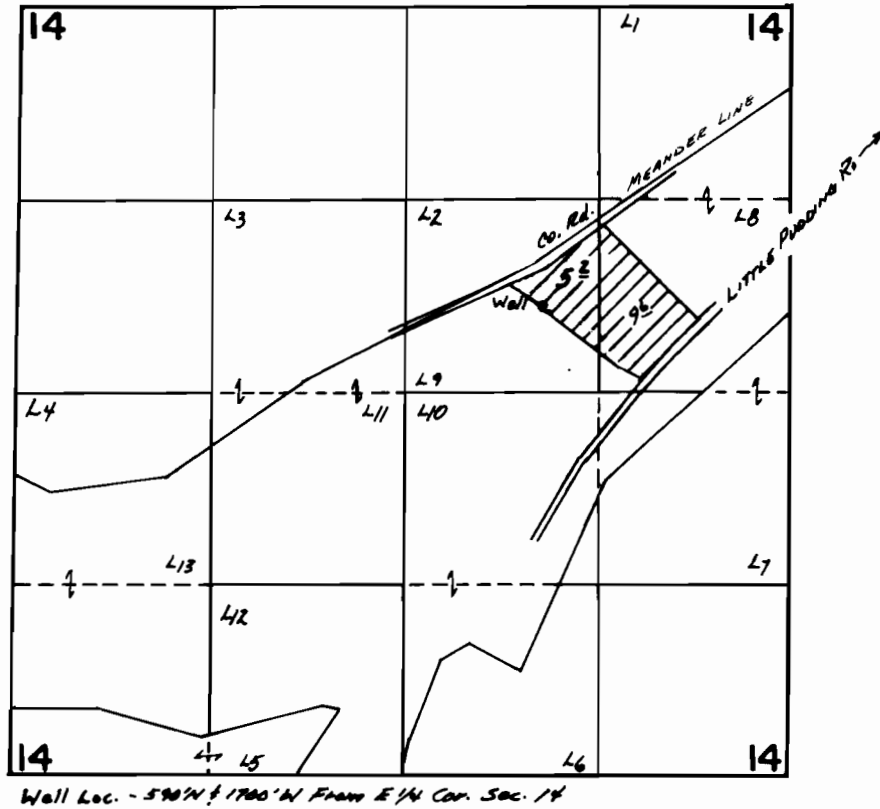

FINAL PROOF SURVEY UNDER

Application No. G-6036. Permit No. G-5268.
IN NAME OF

ANNA MCGUIRE

Surveyed April 15, 1977, by L.H.NUNN