


T.6S., R.1W., W.M.

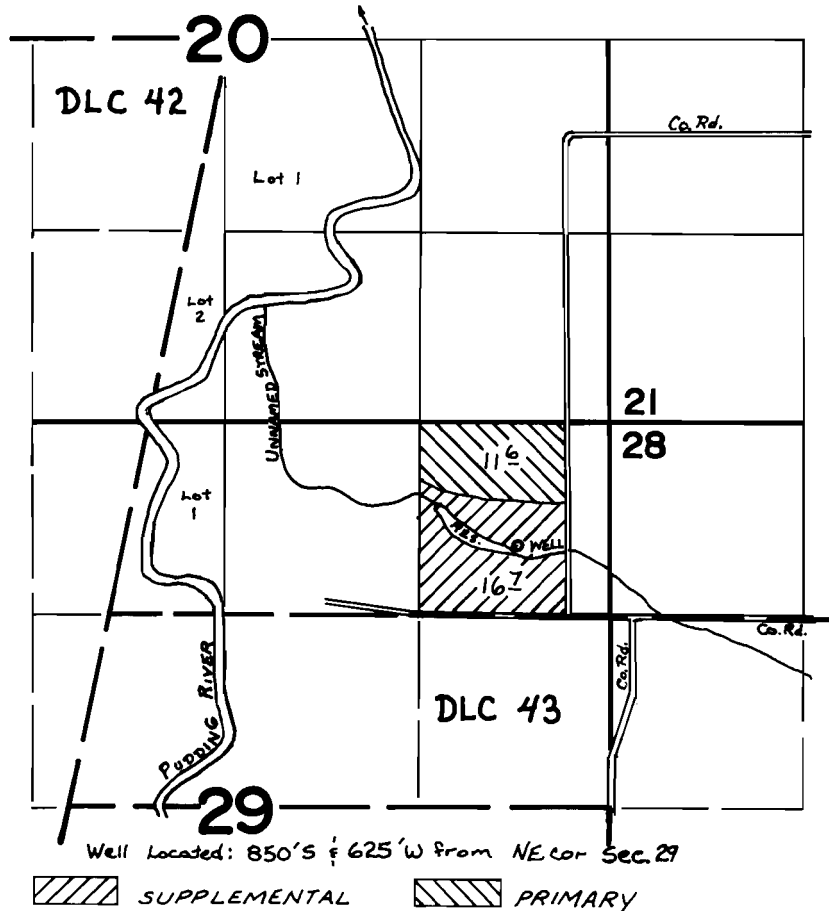

FINAL PROOF SURVEY UNDER

Application No. G-6660 Permit No. G-6218
IN NAME OF

JAMES BEYER

Surveyed SEPT. 6 1977, by D. NORBY