


T.6S. R.2W. W.M.

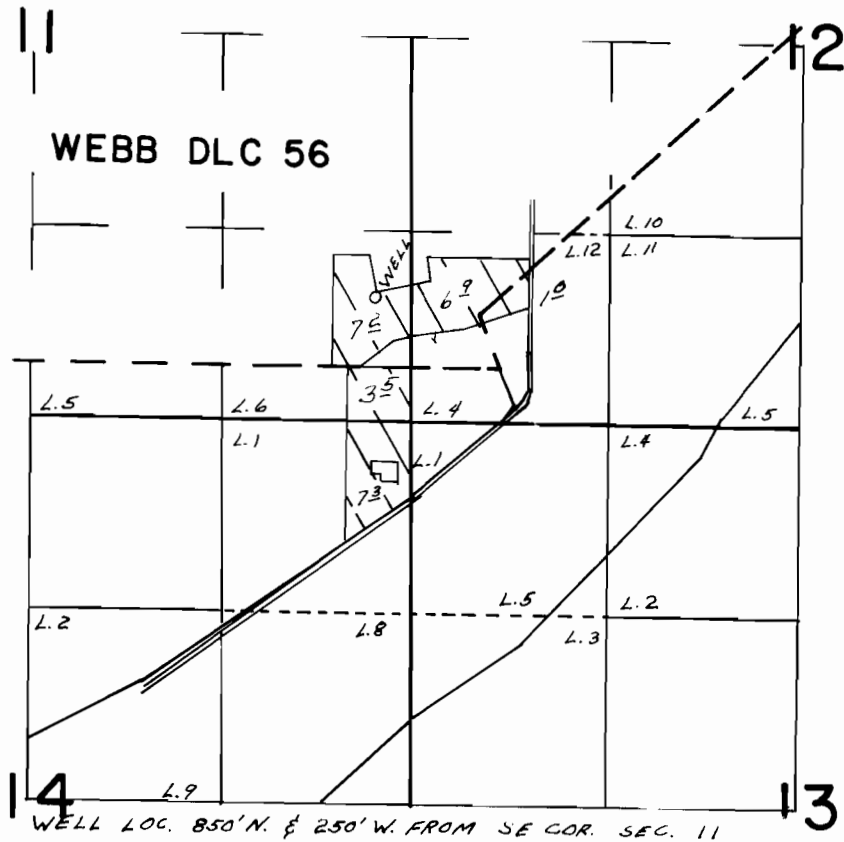

**FINAL PROOF SURVEY**  
UNDER

Application No. G-6919... Permit No. G-6440...  
IN NAME OF

DENNIS E. McCLAUGHRY

Surveyed APR. 15. 1977., by L.H. NUNN.....