


T.6S. R.1W. W.M.

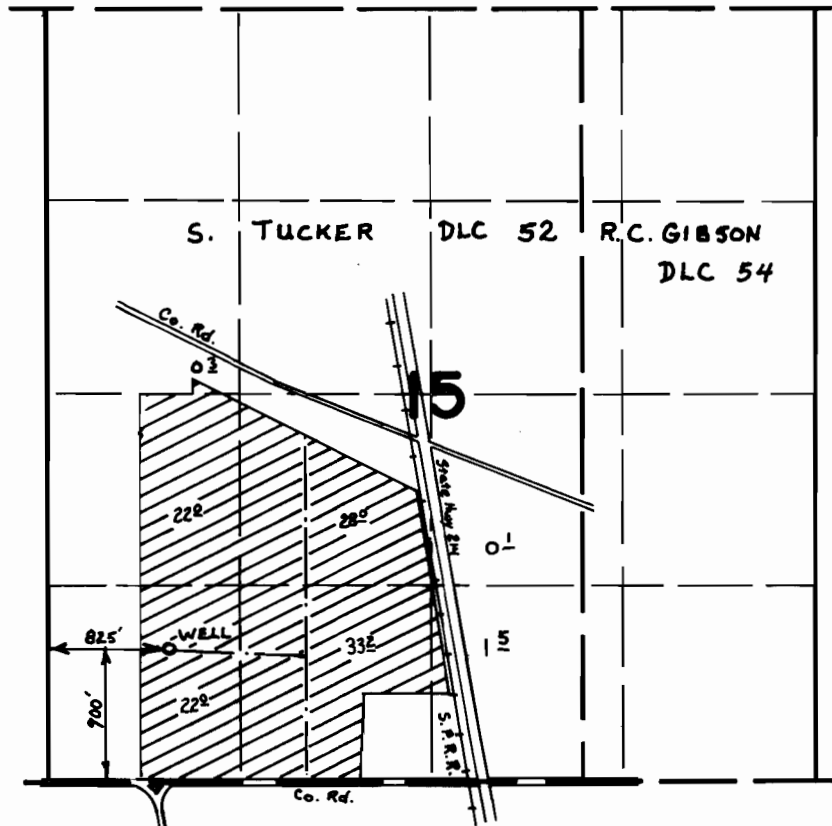

FINAL PROOF SURVEY UNDER

Application No. G-7298 Permit No. G-6749
IN NAME OF

CHARLES D. WAVRA

Surveyed Sept. 7 1977, by D. Norby