


T.9S.,R.4W.,W.M.

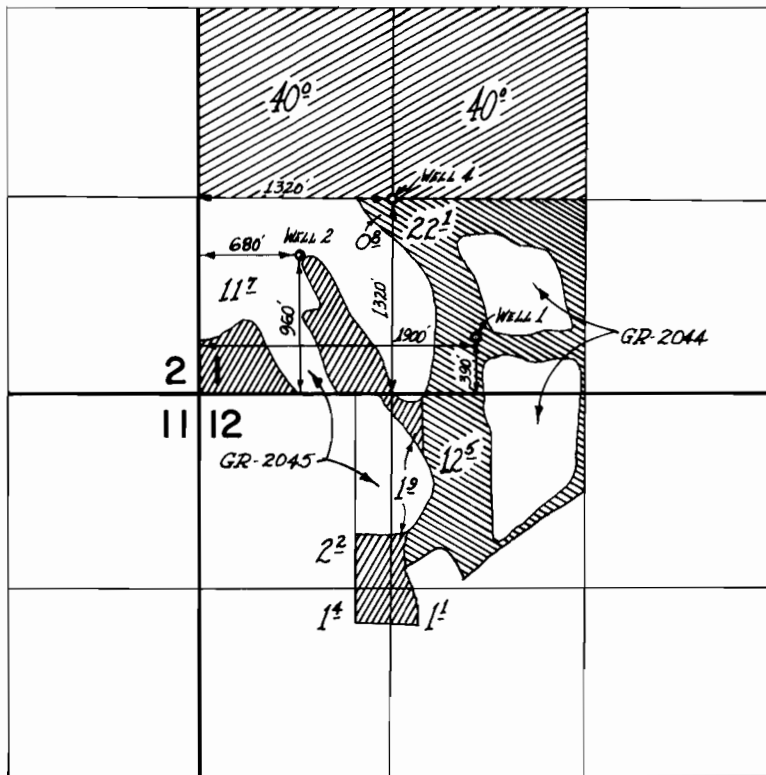

-  — WELL No. 2
-  — WELL No. 4
-  — WELL No. 1

FINAL PROOF SURVEY UNDER

Application No. G-7051 Permit No. G-6009
IN NAME OF

..... DOUGLAS R. HADLEY

Surveyed July 6, 1977, by L.M. Toll