T. 6 S. R. 5 W. W. M.

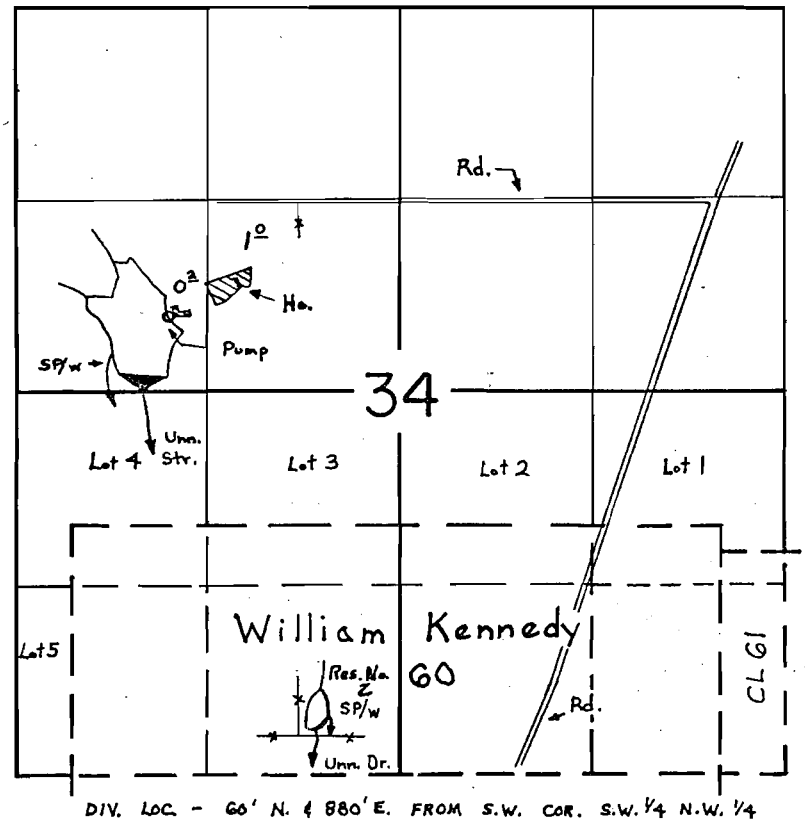

FINAL PROOF SURVEY

UNDER

R-47585 R-5606

47586 34968

Application No. R-47288 Permit No. R-5697

IN NAME OF

DALE A. DAVISON

Surveyed June 3 19 76, by R. G. Mucken

DHM

1976 - 7