


T. 6 S. R. 5 W. W. M.

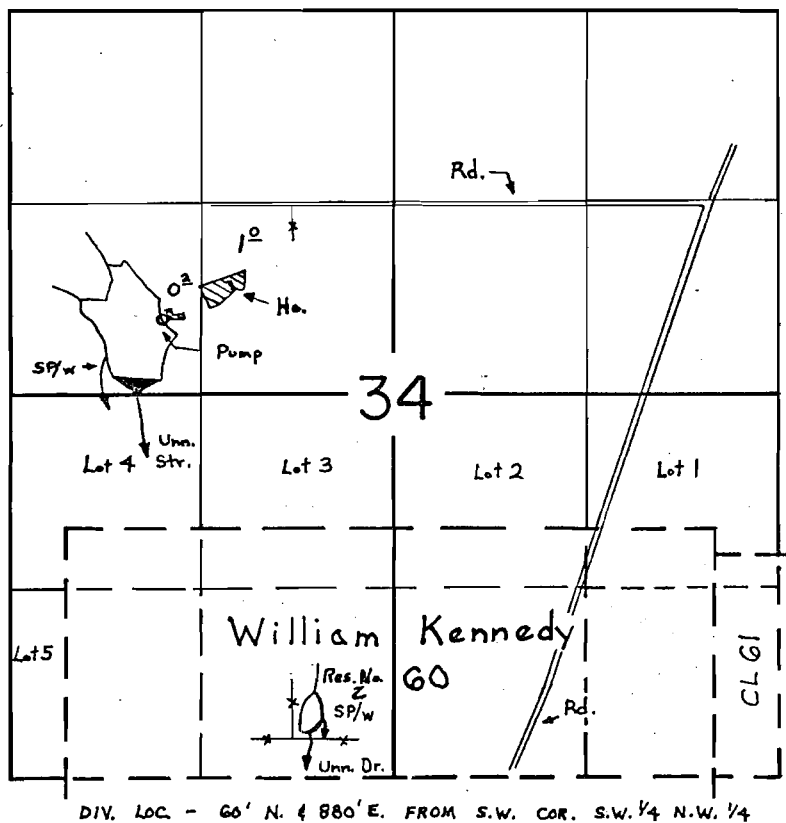

**FINAL PROOF SURVEY**

UNDER

R-47585

R-5606

47586

34968

Application No. ~~R-47288~~ Permit No. ~~R-5697~~

IN NAME OF

DALE A. DAVISON

Surveyed June 3, 1976, by R.G. Mucken