T.7S. R.6W. W.M.

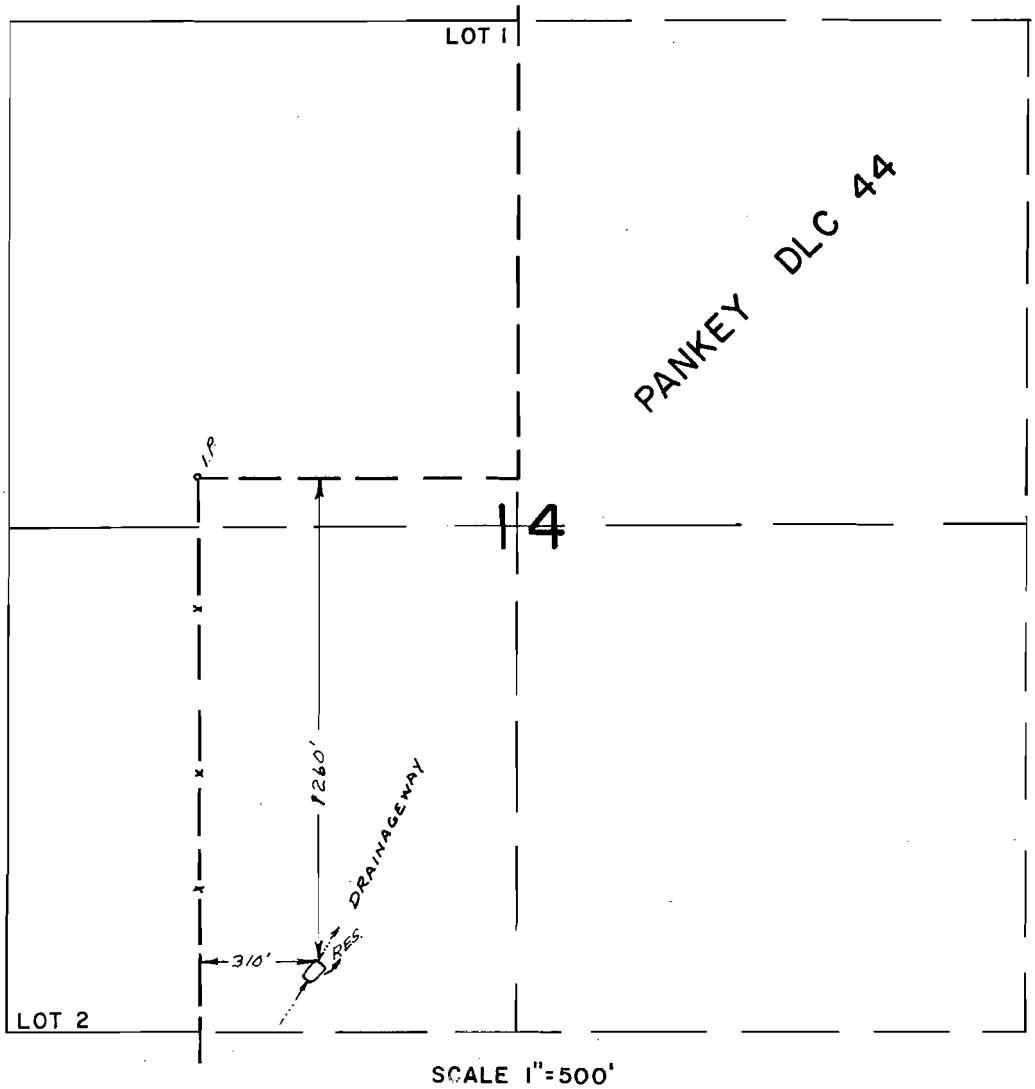

SCALE 1"=500'

FINAL PROOF SURVEY
UNDER

Application No. R-52869 52870 Permit No. R-6419 40293
IN NAME OF

TED MOLINARI

Surveyed APR. 14 1977, by L.H. NUNN

1977-P