


T.6S.,R.6W.,W.M.

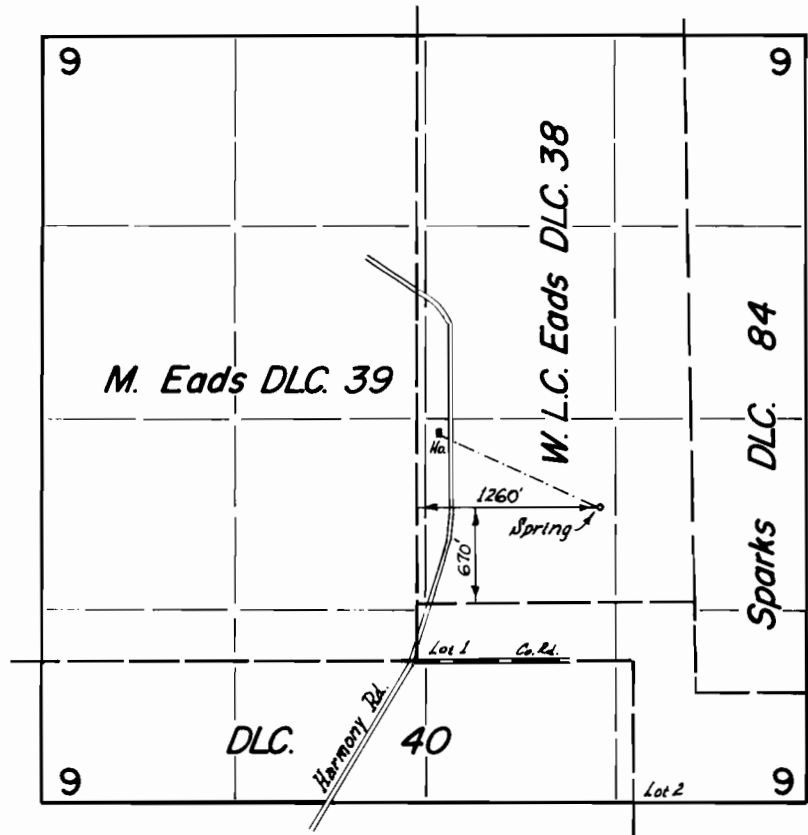

FINAL PROOF SURVEY
UNDER

Application No. 52926 Permit No. 39961
IN NAME OF

CECIL A. & HENRY CLAY MIZE

Surveyed Aug. 10 1977, by L.M. Toll