


G 5963
48080

T.2N.,R.33E.,W.M.

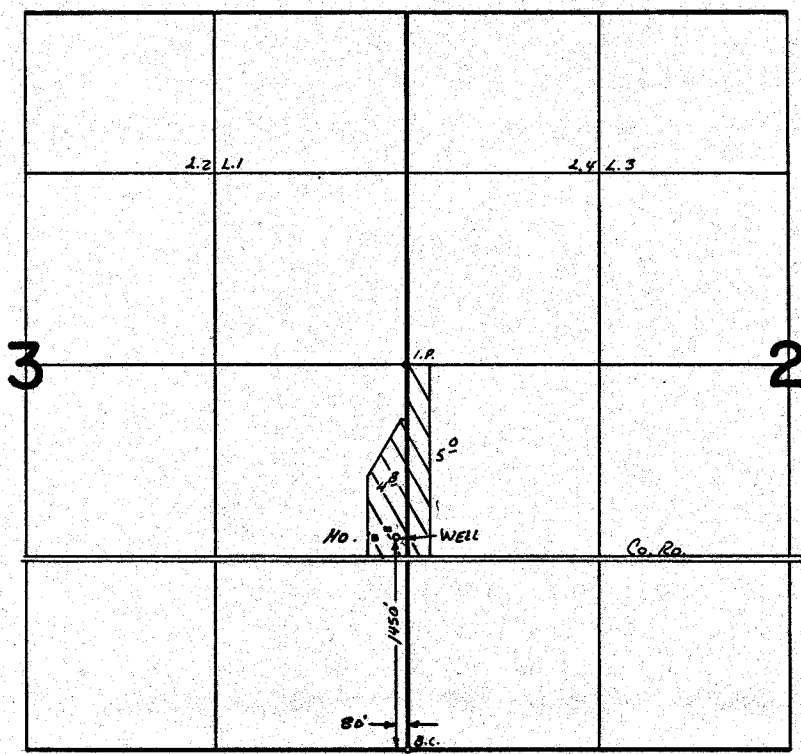

FINAL PROOF SURVEY UNDER

Application No. G-6367. Permit No. G-5963.
IN NAME OF

GERALDINE I. SHROLL

Surveyed APRIL 10, 1976, by L. Toll