


T.6N.,R.35E.,W.M.

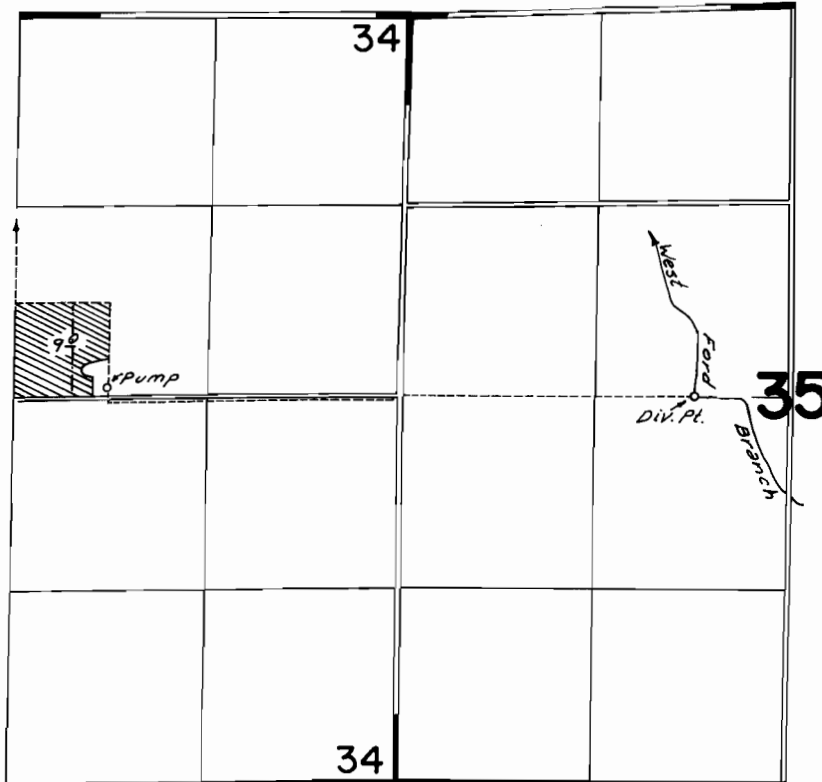

Div. Pt. Loc.: 2000' E. from W. $\frac{1}{4}$ Cor. Sec. 35

FINAL PROOF SURVEY UNDER

Application No. 51840 Permit No. 39035
IN NAME OF

Jack D. & Juanita Slusarenko

Surveyed Apr. 7, 1976, by C. R. King