


T.2N. R.33E. W.M.

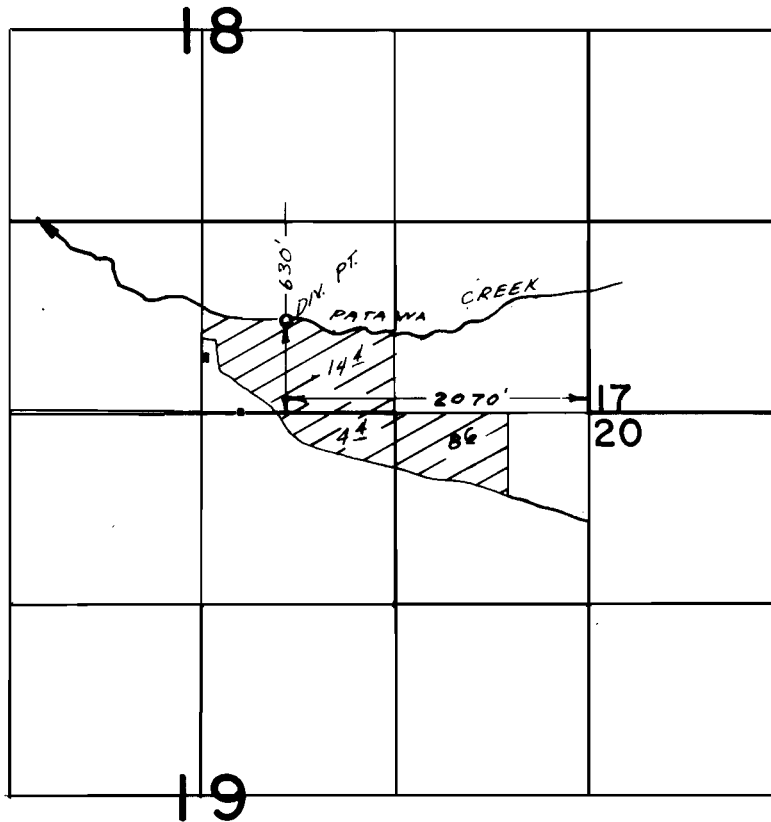

**FINAL PROOF SURVEY**  
UNDER

Application No. 52046..... Permit No. 39224.....  
IN NAME OF

..... C. C. CURL, JR. ....

Surveyed MAY 3 1977, by L.H. NUNN.....