


T.3N. R.32E. W.M.

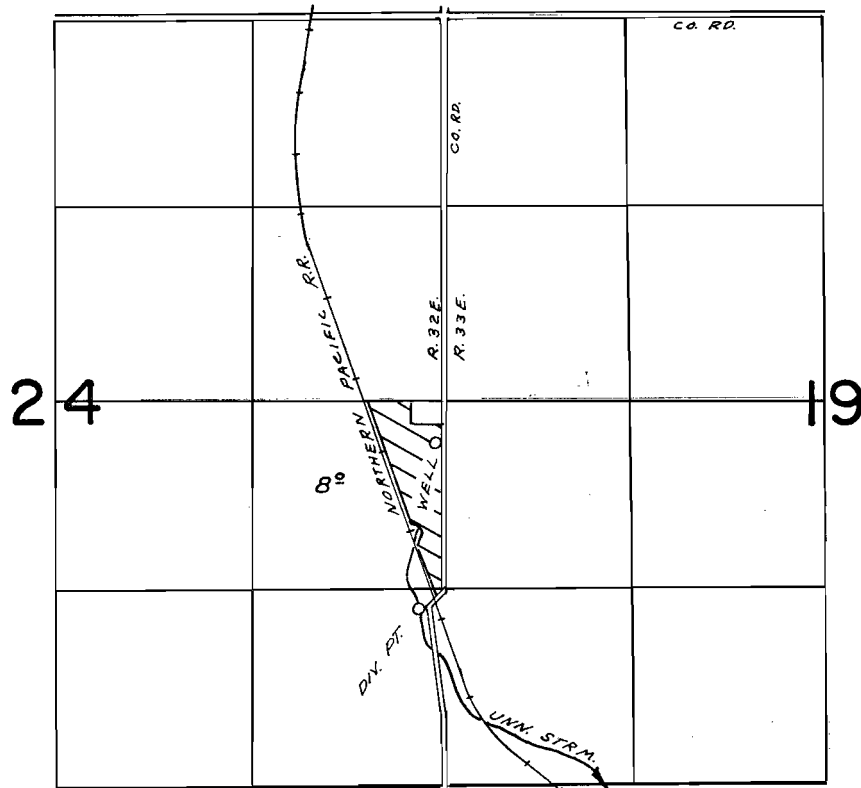

DIV. PT. LOC. 1420'S. & 170' W.; WELL LOC. 280'S. & 50' W. BOTH FROM E. 1/4 COR. SEC. 24.

FINAL PROOF SURVEY
UNDER

Application No. 53823 39929
G-7197 Permit No. G-6627.
IN NAME OF

MARK A. ROSENBERG

Surveyed MAY 2 1977, by L.H. NUNN