


# T.4S. R.13E. W.M

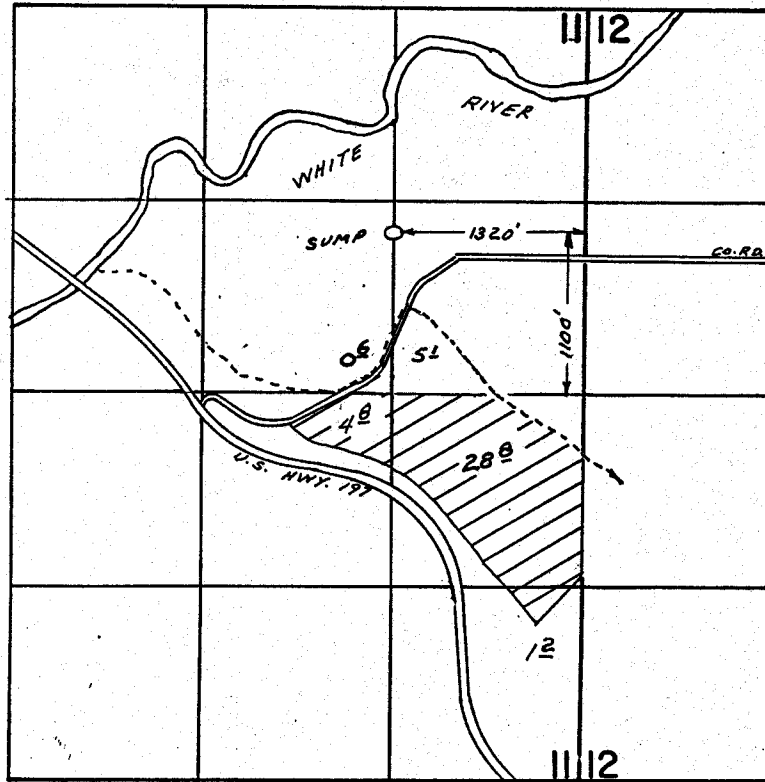

## FINAL PROOF SURVEY UNDER

Application No. G-5696. Permit No. G-5505.  
IN NAME OF

FRED W. & LEANA D. ASHLEY

Surveyed SEP. 14. 1977, by L.H. NUNN.....