


C 48089
48486

T.4S.R.12E.W.M.

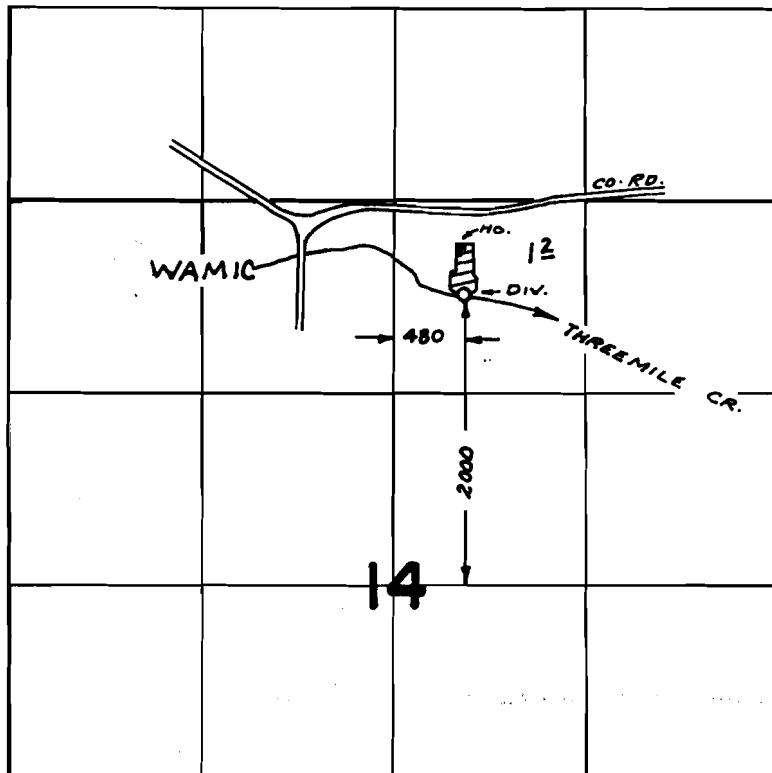

FINAL PROOF SURVEY UNDER

Application No. 49346 Permit No. 37354
IN NAME OF

A. E. & NORA ARCHER

Surveyed APR. 8, 1976, by R. MUCKEN

37354
472-67