


T. 1N. R. 2W. W.M.

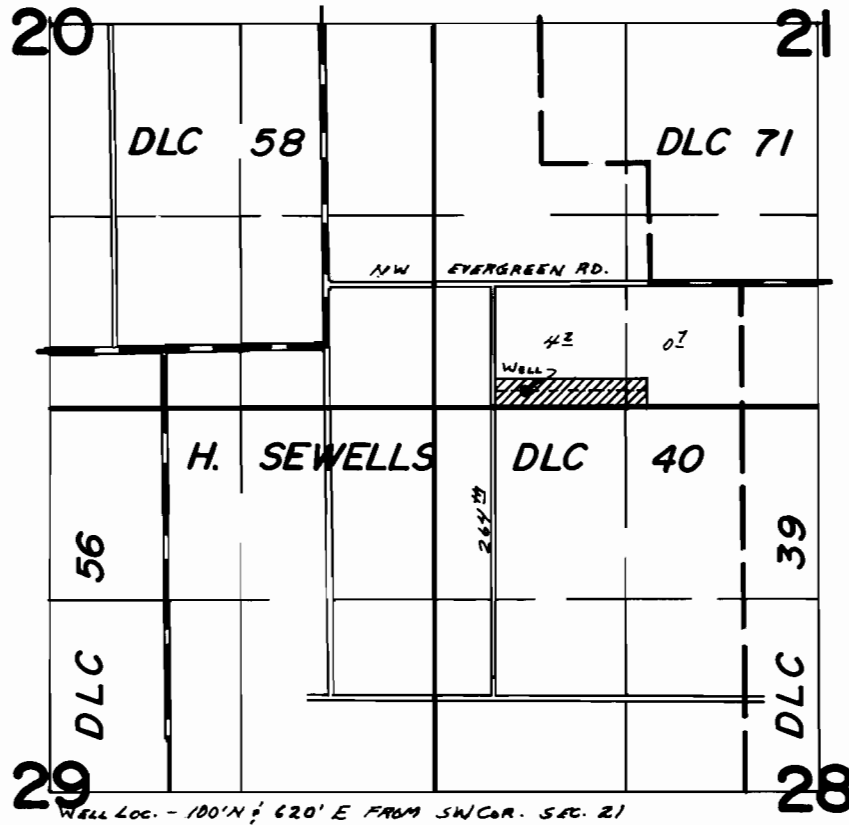

FINAL PROOF SURVEY
UNDER

Application No. G-7376.. Permit No. G-6823..
IN NAME OF

.....RUSSELL A. THOMPSON.....

Surveyed MAY 6 1977, by D.M. NORBY.....