


T.2N.R.4W.W.M.

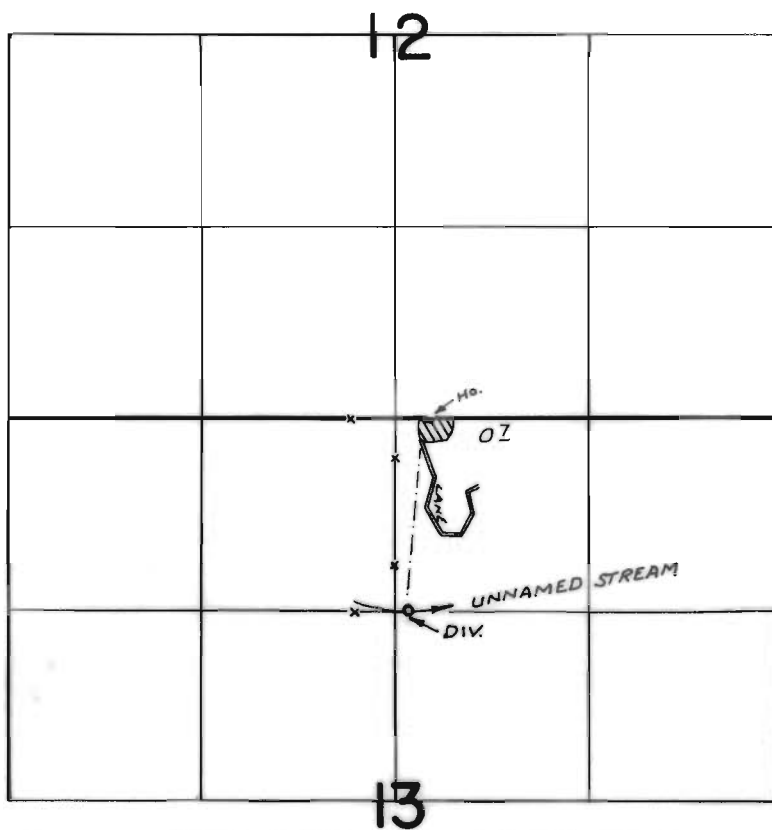

DIV. LOC: 1320'S. & 80'E. FROM N $\frac{1}{4}$ COR. SEC. 13

FINAL PROOF SURVEY
UNDER

Application No. 51766 Permit No. 39009
IN NAME OF

DONALD JOHN HEINO

Surveyed MAY 19, 1976, by R. MUCKEN