


T. 7S. R. 21E. W.M.

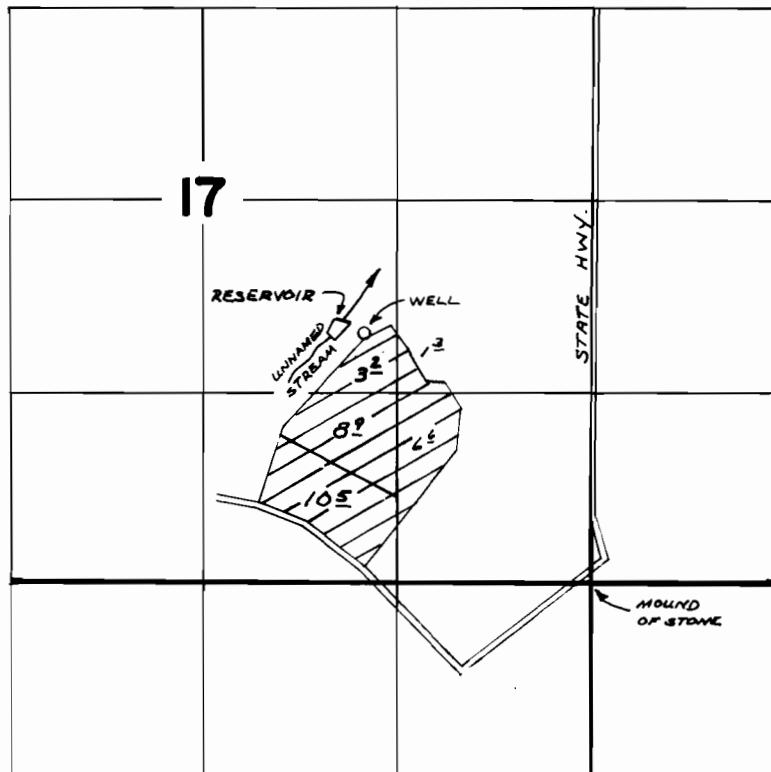

WELL LOCATED 1740' N. & 1560' W. OF SE CORNER SEC 17
DAM LOCATED 1530' N. & 1700' W. OF SE CORNER SEC 17

FINAL PROOF SURVEY
UNDER

52234

39175

R52005

R 6273

Application No. G 6609 Permit No. G 6191
IN NAME OF

RONALD W. & MARJORIE SKITES

Surveyed AUG 25 1977, by R.G. MUCKEN