


T.2S. R.5W. W.M.

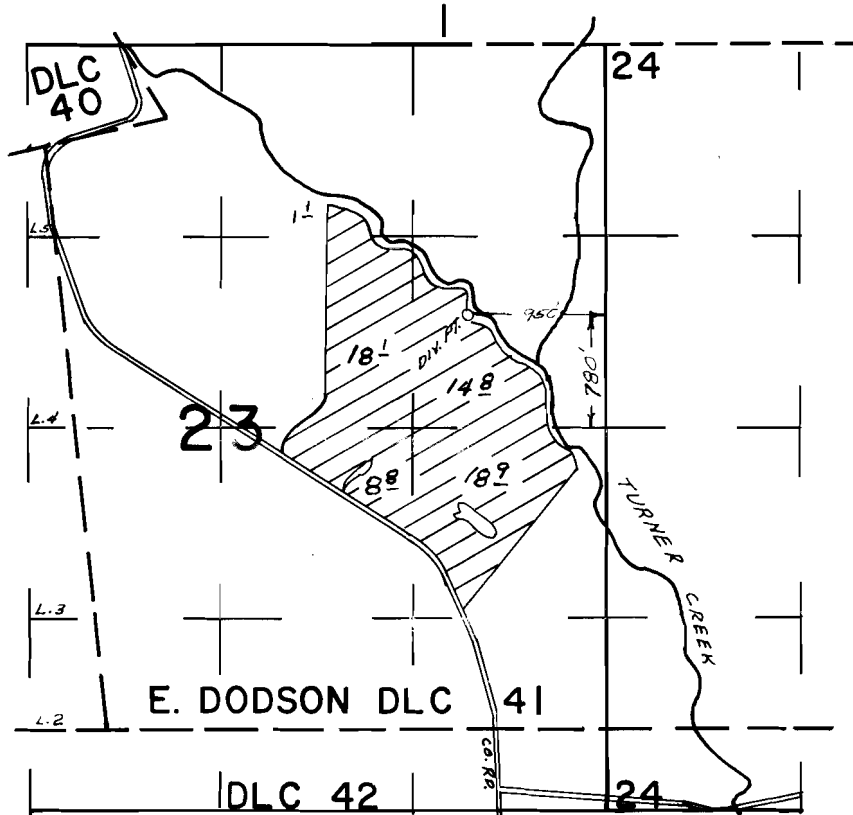

FINAL PROOF SURVEY
UNDER

Application No. 49988..... Permit No. 37595.....
IN NAME OF

.....HARLEY BELT.....

Surveyed OCT. 6..... 19.77, by L.H. NUNN.....