


T.4 & 5S. R.4W. W.M.

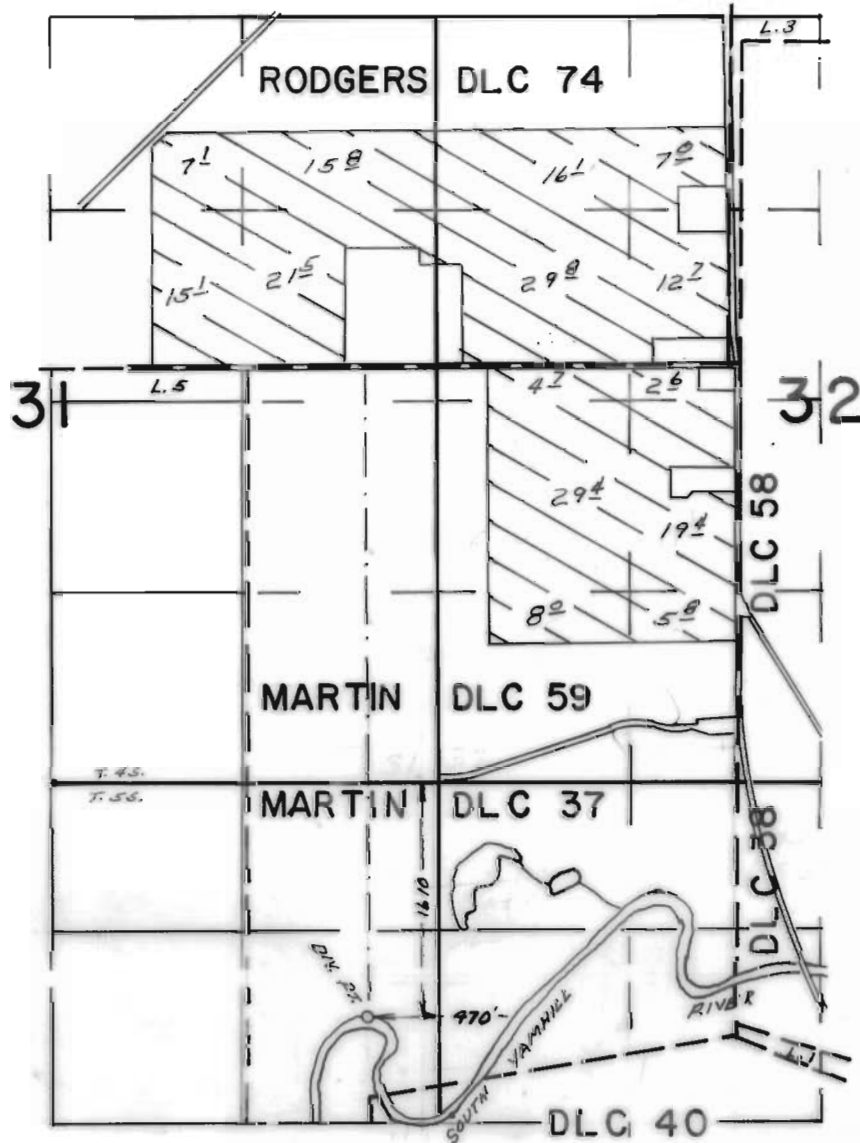

**FINAL PROOF SURVEY**  
UNDER

Application No. 51618 Permit No. 37397  
IN NAME OF

RANDY COLEMAN

Surveyed AUG. 12. 19.77. by L.H. NUNN