


T.4S. R.4W. W.M.

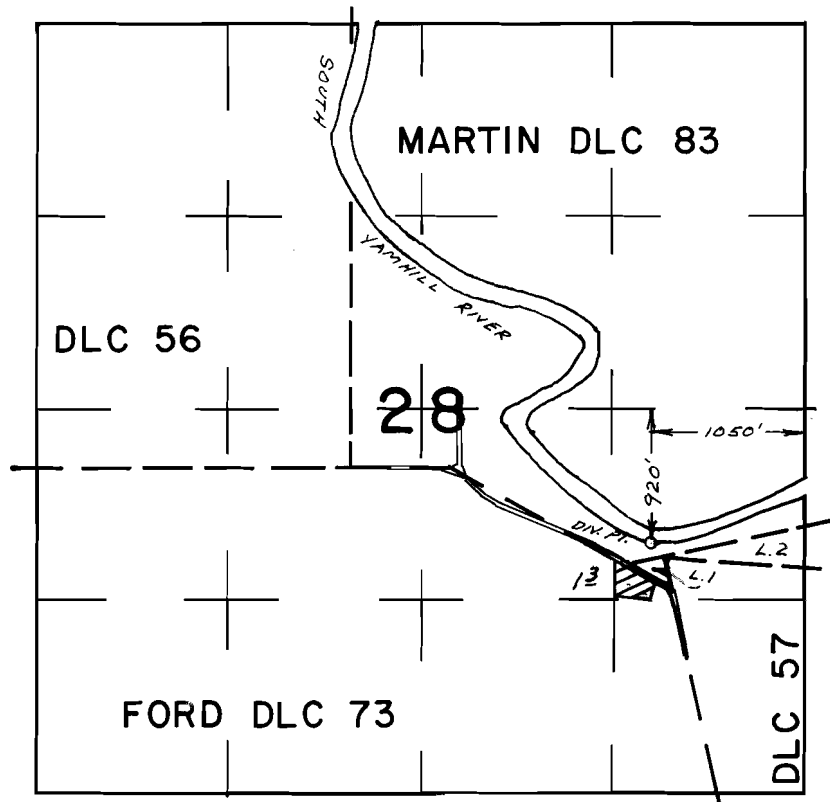

**FINAL PROOF SURVEY**  
UNDER

Application No. 53199..... Permit No. 39476.....  
IN NAME OF

JAMES R. McBRIDE

Surveyed AUG. 11, 1977, by L.H. NUNN