T.5 S.R.6 W.W.M.

RECEIVED
JUL 9 1975
WATER RESOURCES DEPT.
SALEM, OREGON

Application No. 53394
Permit No. 39741

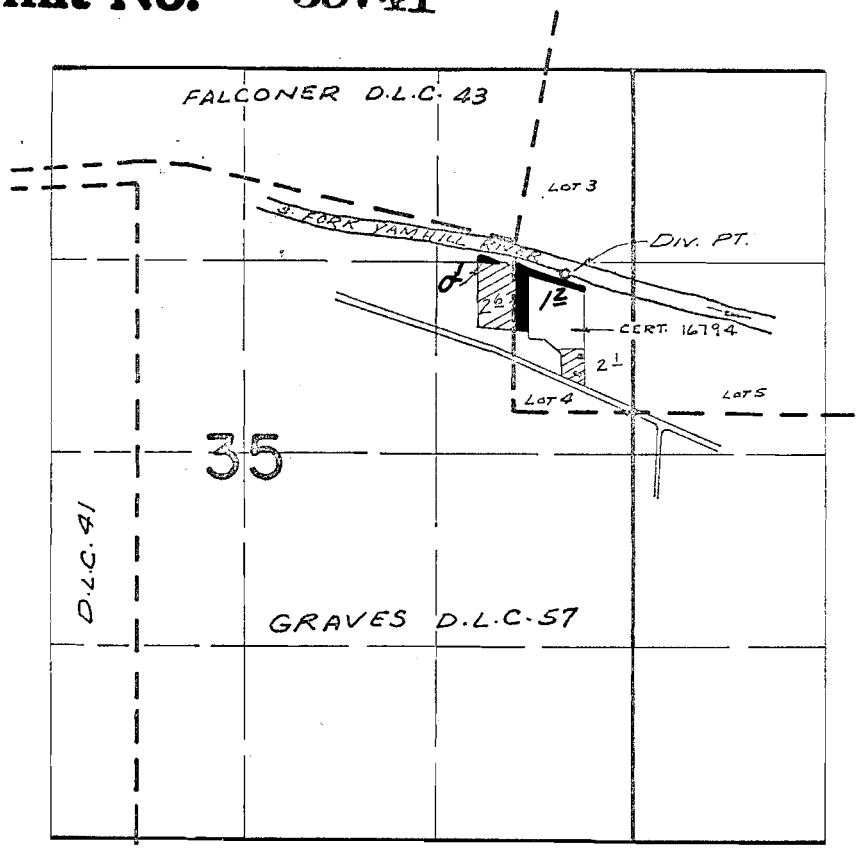

DIV. PT. LOC: 230'S. & 350'E. FROM S.E. COR. FALCONER D.L.C. 43

FINAL PROOF SURVEY
UNDER

Application No. 46703 Permit No. 34900
IN NAME OF

ELMER W. JACKSON

Surveyed FEB. 13. 1973., by R. MUCKEN