


# T.4S. R.4 W., W.M.

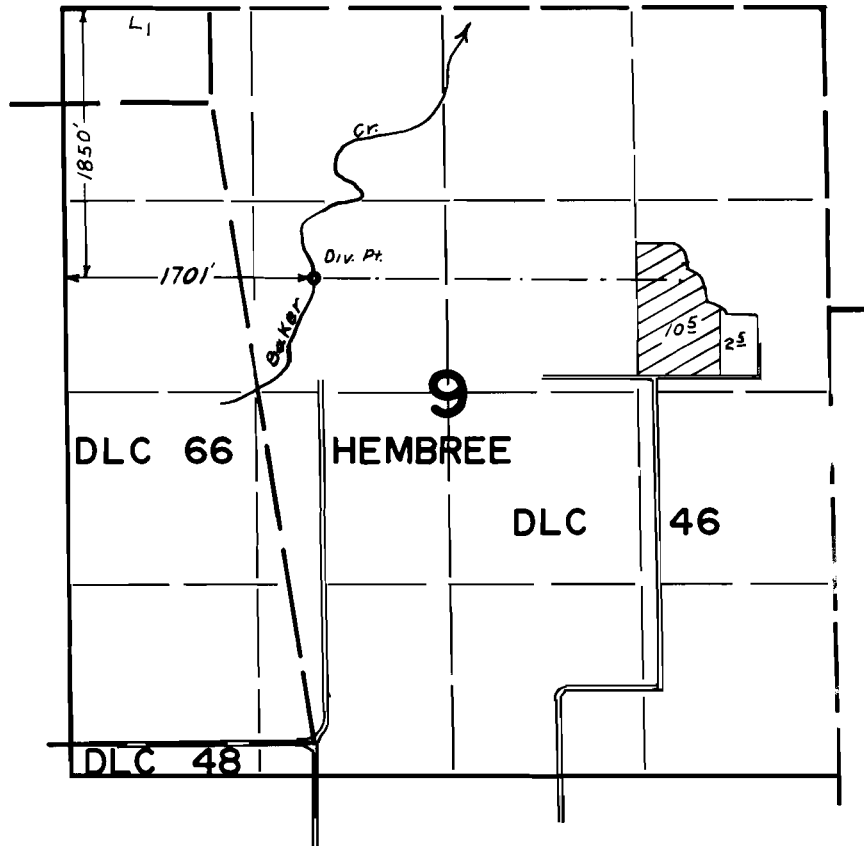

## FINAL PROOF SURVEY UNDER

Application No. 54028 Permit No. 40413  
IN NAME OF

HERBERT C. COLEMAN

Surveyed SEP. 9 1977, by L. H. NUNN