


T.2S. R.5W. W.M.

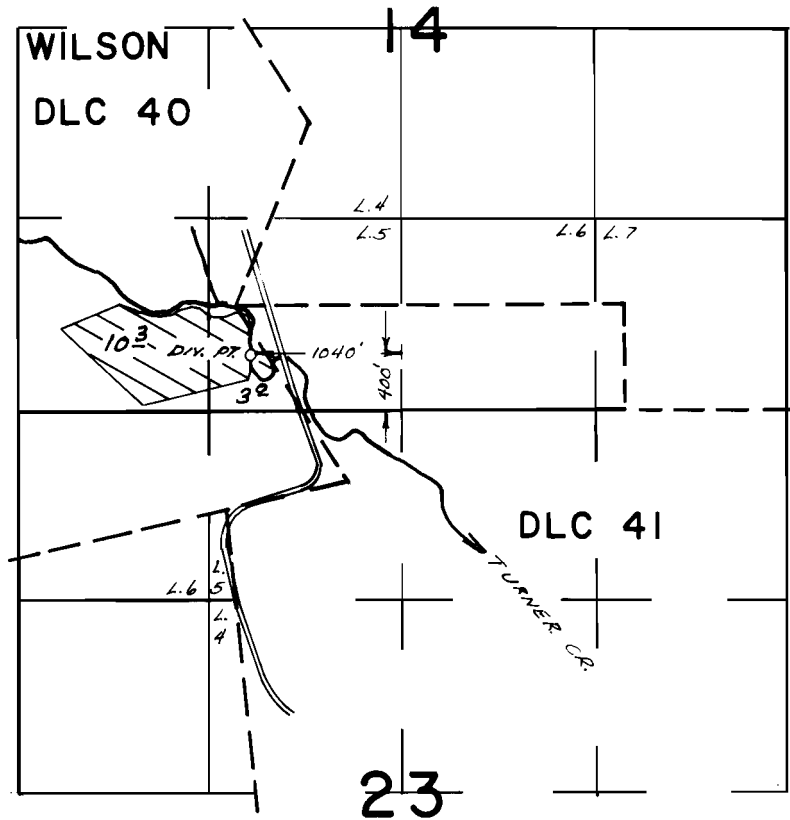

**FINAL PROOF SURVEY**  
UNDER

Application No. 54219..... Permit No. 40618.....  
IN NAME OF

HARLEY BELT

Surveyed OCT. 6... 1977., by L.H. NUNN.....