


T.10S.,R.6W.,W.M.

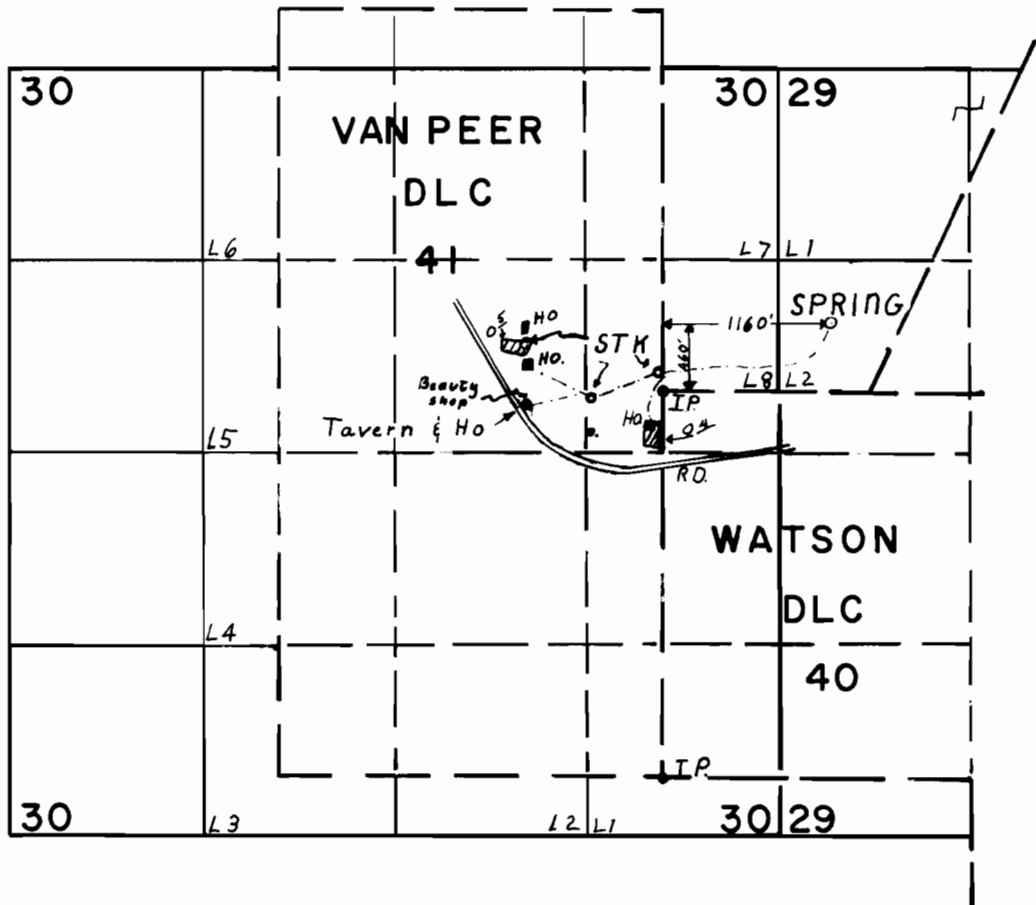

FINAL PROOF SURVEY
UNDER

Application No. 51515 Permit No. 38878
IN NAME OF

.....
AUDREY & VERLE THEURER
.....

Surveyed MAR.29. 1976. by C.R. KING.....