


T.13S.R.6W.W.M.

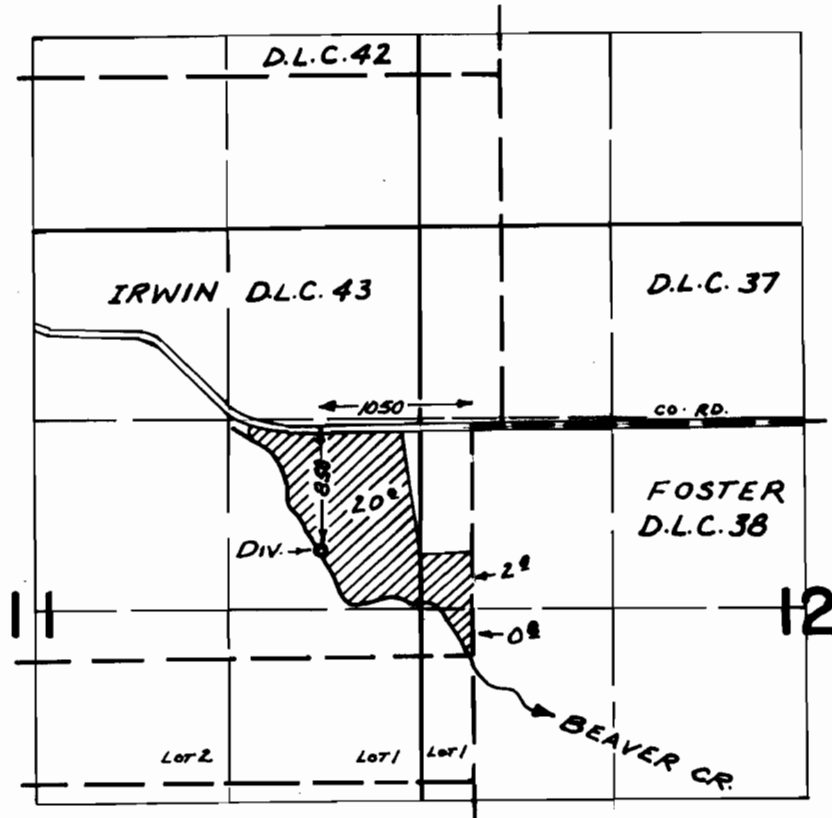

FINAL PROOF SURVEY UNDER

Application No. 52606... Permit No. 39666...
IN NAME OF

ALEX & BETTY WALLACE

Surveyed AUG. 18 1977, by Bob BARNIX