


T2S. R3E. WM.

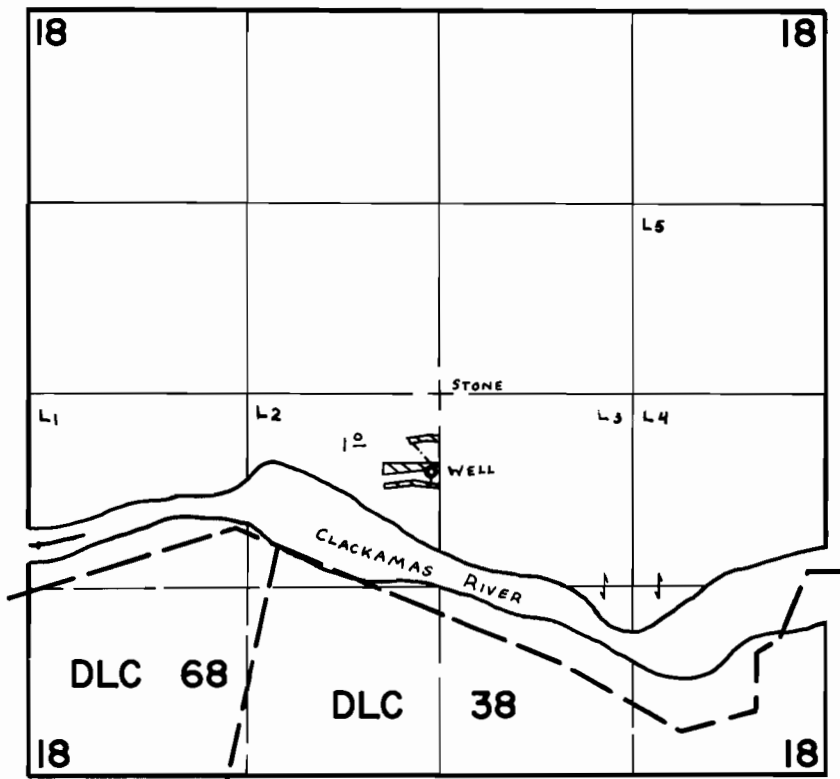

WELL LOC: 530' S & 60' W. fr. C. 1/4 COR. SEC. 18.

FINAL PROOF SURVEY UNDER

Application No. G-7747 Permit No. G-7176
IN NAME OF

CLYDE H. & VIRGINIA L. RICE

Surveyed OCT. 2. 1978. by C. L. HUGHES