


T4S. R3E. WM.

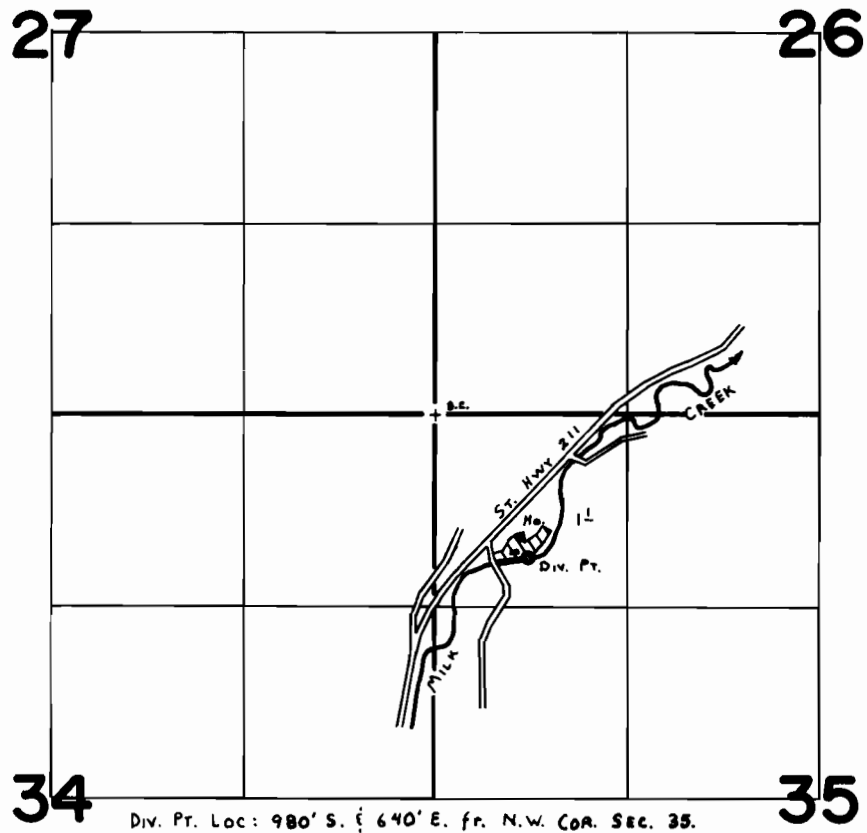

**FINAL PROOF SURVEY**  
UNDER

Application No. 52863 Permit No. 39947  
IN NAME OF

**GEORGE & MAXINE EBY**

Surveyed AUG. 3, 1978, by C. L. HUGHES