# T.5N.,R.4W.,W.M.

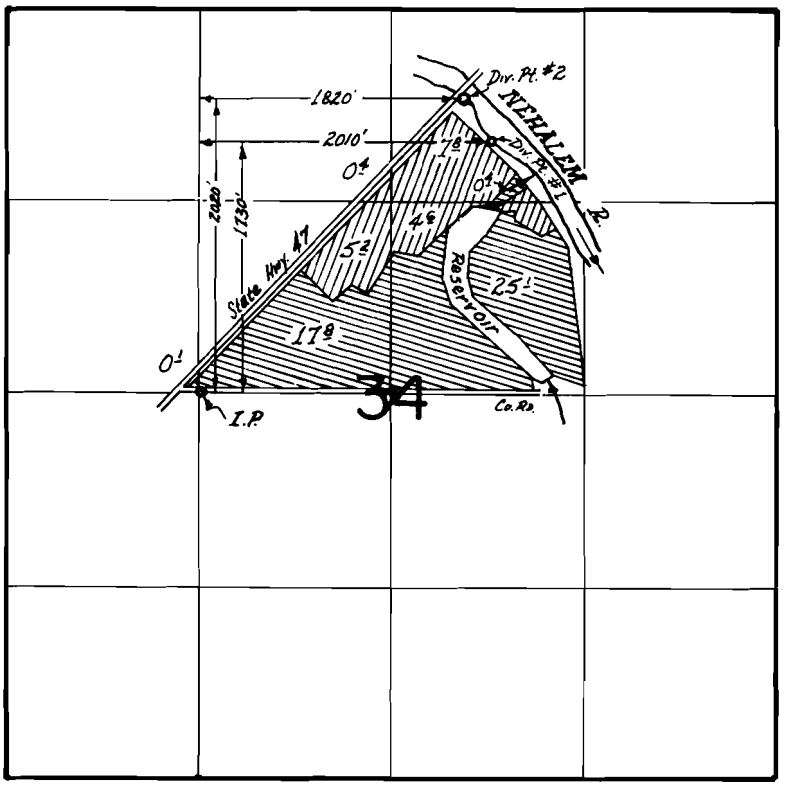


## FINAL PROOF SURVEY
UNDER

| | | | |
|---|---|---|---|
| | 18089 | 13869 | |
| Application No. 53919 | Permit No. 40229 | | |

IN NAME OF

FRANK REED

Surveyed Sept. 19 1978, by S.G. Applegate

1978-F