



T.28 & 29S. R.14W. W.M.

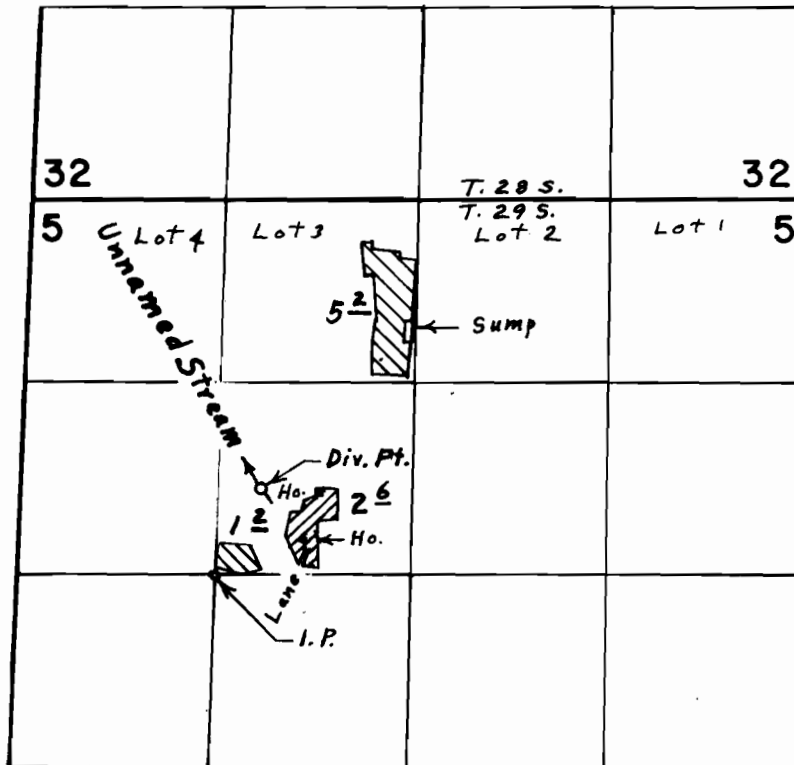

Div. Pt. located 590' N. & 330' E. from S.W. Cor. S.E. $\frac{1}{4}$ N.W. $\frac{1}{4}$ Sec. 5

Cranberries
Lawn & Pasture

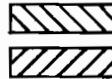

FINAL PROOF SURVEY UNDER

Application No. 43200. Permit No. 32295...
IN NAME OF

D. B. ELLIOTT

Surveyed July 17, 1976, by L. E. Gould...