


T. 29S. R. 12W. W.M.

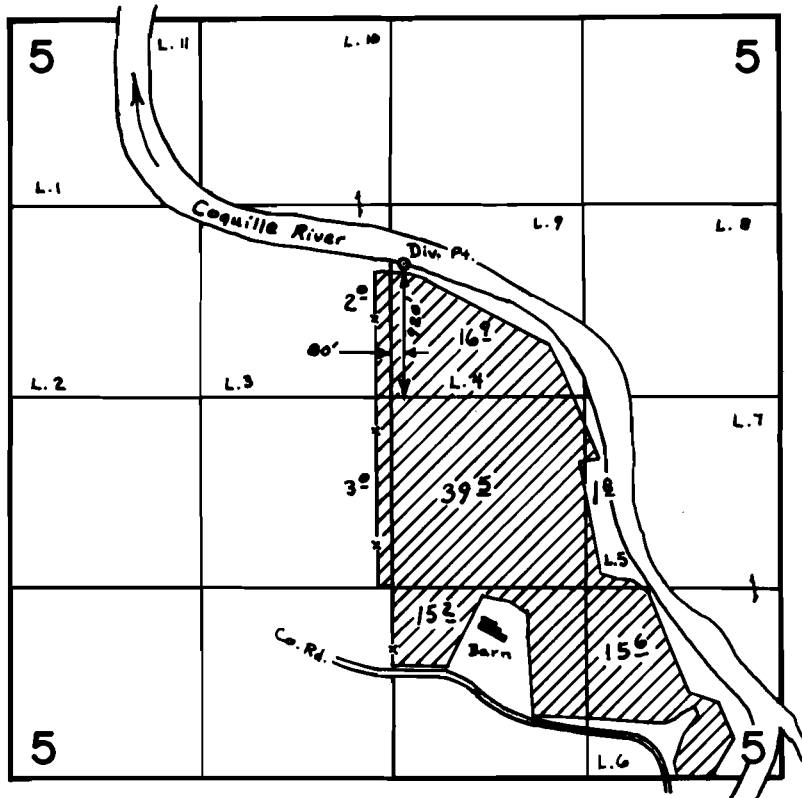

SCALE: 1" = 1320'

FINAL PROOF SURVEY
UNDER

Application No. 55692 Permit No. 41716
IN NAME OF

JOE TEIXEIRA

Surveyed Aug. 8, 1978, by D. Sparks