


T.13S. R.16E. W.M.

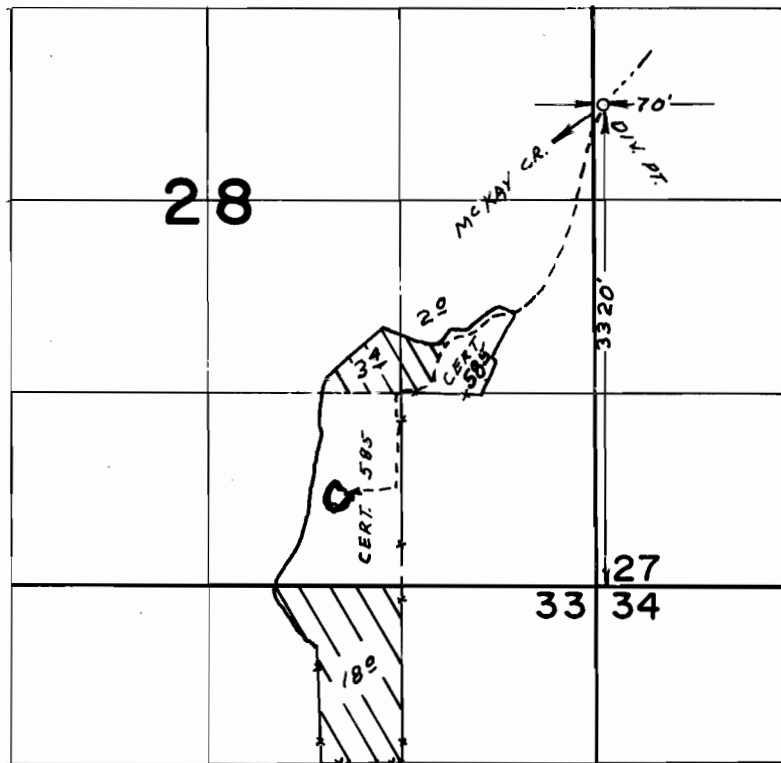

FINAL PROOF SURVEY
UNDER

Application No. 54206... Permit No. 40570...
IN NAME OF

.....HARRY POLLARD.....

Surveyed JUN. 9... 1978., by L.H. NUNN.....