


T. 30S., R. 4W., W.M.

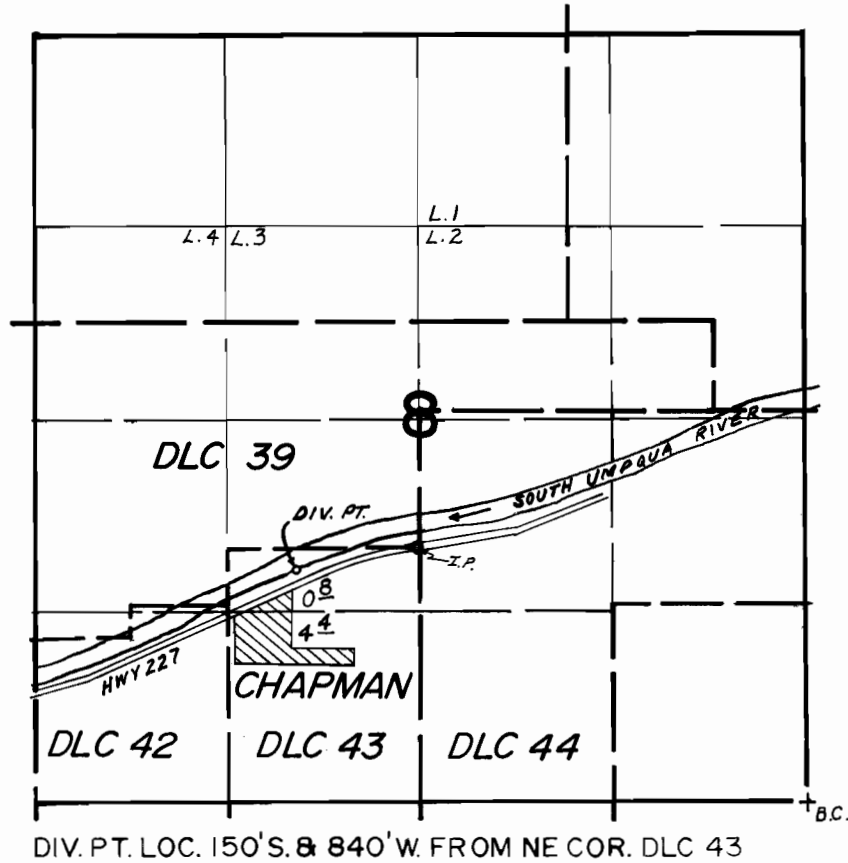

FINAL PROOF SURVEY
UNDER

Application No. 48276 Permit No. 36259
IN NAME OF

GEORGE V. &/OR MARION E. HUMPHREYS

Surveyed APR. 29. 19.77, by D.M. NORBY.....