


RECEIVED

T-3093

JUL 16 1974

STATE ENGINEER
SALEM, OREGON

T. 30 S., R. 5 W. W. M.
Scale 4 inch = 1 mile

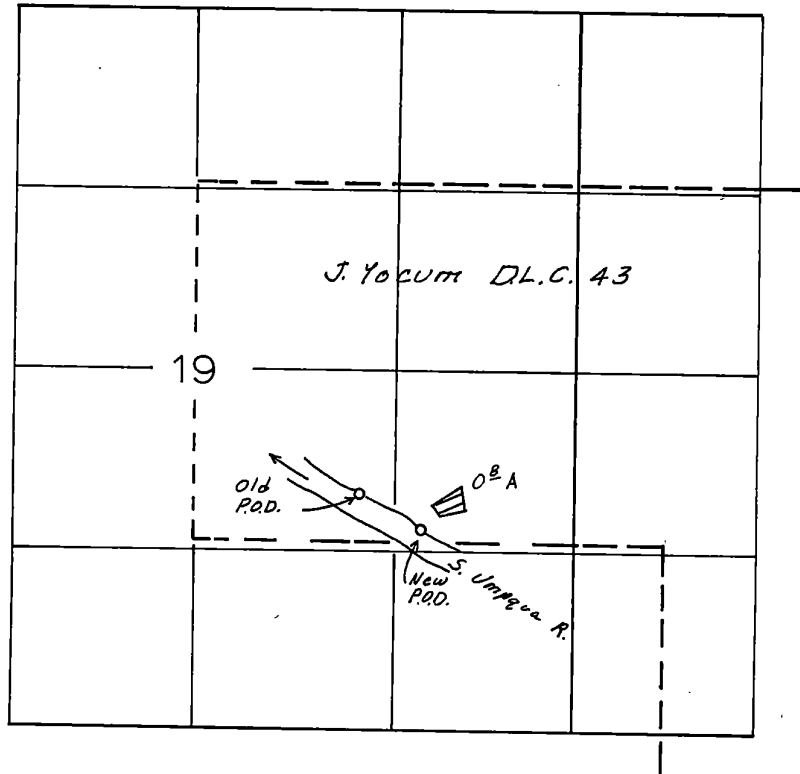

Old P.O.D. located 1750' N. and 1075' E. from
the south 1/4 cor. of Sec. 19.

New P.O.D. located 1460' N. and 2445' W. from
the S.E. cor. of Sec. 19.